

Pike
 H 2018
 9-24-80

MISSISSIPPI
 BOARD OF WATER COMMISSIONERS
 416 North State Street
 Jackson, Mississippi 39201

WATER WELL DRILLERS LOG

9-24 1980 *Fitzgerald well serv* *Pike*
 date well completed firm name county well located

LANDOWNER:	description of formations encountered	from	to
<i>Mike Lovencroft</i>	<i>Red Clay</i>	<i>0</i>	<i>20</i>
<i>RR- Magnolia</i> (mailing address)	<i>Red Sand</i>	<i>20</i>	<i>100</i>
WELL LOCATION: sec. <i>36</i> T. <i>2</i> N. R. <i>8</i> E S W <i>8</i> miles <i>SE</i> of <i>Magnolia</i> (distance) (direction) (nearest town)	<i>Coarse sand gravel</i>	<i>100</i>	<i>128</i>
WELL PURPOSE: <i>Home</i> (home, irrigation, municipal, industrial)			
WELL COMPLETION DATA: (1) diameter (inches) <i>4</i> (2) total depth (feet) <i>128</i> (3) static water level (feet) <i>85</i> below above top of ground. (4) casing <i>ROC</i> , <i>120</i> (material) (depth) <i>4</i> if telescope see back. (size) (5) screen <i>8</i> , <i>120</i> (length) (depth to top) <i>1/2</i> , <i>ROC</i> (size) (material) (6) pump <i>1/2</i> , <i>10</i> (HP) (yield gpm) <i>elec</i> (type power) (7) electric log <i>no</i> (yes or no) _____ (organization running log) (8) how well bottom plugged <i>Sand plug</i>			

DEPT. OF NATURAL RESOURCES
 BUREAU OF LAND & WATER


DEC 9 1980

RECEIVED

DRILLERS REMARKS:

If well telescopes please sketch and show depths.

GROUND LEVEL

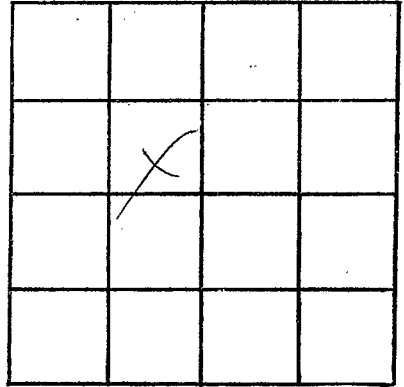

SECTION 36

Please indicate well location X.

ADDITIONAL INFORMATION

If more than one screen, show locations of each on sketch.