

MISSISSIPPI DEPARTMENT OF NATURAL RESOURCES

Bureau of Land and Water Resources

Southport Mall

P.O. Box 10631

Jackson, Mississippi 39209

WATER WELL DRILLERS LOG

Pike
H 2009
2/29/80

Feb 29 19 Reeves well serv Pike
 date well completed firm name county well located

LANDOWNER:	description of formations encountered	from	to
<u>Dwight Pinner</u> <u>Rt Magnolia</u> (mailing address)			
WELL LOCATION: sec. <u>24</u> T <u>2</u> N R <u>8</u> E <u>6 1/2</u> miles <u>ESE</u> of <u>Magnolia</u> (distance) (direction) (nearest town)			
WELL PURPOSE: <u>Home</u> (home, irrigation, municipal, industrial)			
WELL COMPLETION DATA: (1) diameter (inches) <u>4"</u> (2) total depth (feet) <u>137</u> (3) static water level (feet) <u>115</u> below above top of ground. (4) casing <u>plastic bottom</u> (material) (depth) _____ If telescope see back. (size) (5) screen <u>50</u> <u>132</u> (length) (depth to top) <u>4"</u> <u>plastic</u> (size) (material) (6) pump <u>3 1/2</u> <u>12</u> (HP) (yield gpm) <u>elect</u> (type power) (7) electric log <u>no</u> (yes or no) _____ (organization running log) (8) how well bottom plugged <u>washer plug</u>			
DRILLERS REMARKS:			


DEPT. OF NATURAL RESOURCES
BUREAU OF LAND & WATER RESOURCES

DEC - 1 1980

RECEIVED

If well telescopes please sketch and show depths.

GROUND LEVEL

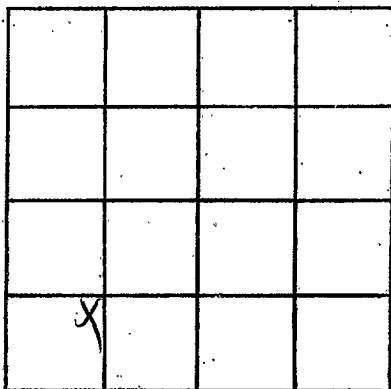

SECTION 24

Please indicate well location X.

ADDITIONAL INFORMATION

If more than one screen,
show locations of each on sketch.