

MISSISSIPPI DEPARTMENT OF NATURAL RESOURCES

Bureau of Land and Water Resources

Southport Mall

P.O. Box 10631

Jackson, Mississippi 39209

WATER WELL DRILLERS LOG

Pike
H 2000
X12-22-80

Dec-22 1980 Revere Well Dr Pipe
date well completed firm name county well located

LANDOWNER:
Martene Barnes
Rt Magnolia
(mailing address)

description of formations encountered	from	to
Red Clay	0	18
Red sand	18	60
gravelly sand	60	72
Chalky sand	72	86
peat gravel	86	90

WELL LOCATION:
sec. 34 T-2 N R-8 E
6 miles S-SE of Magnolia
(distance) (direction) (nearest town)

WELL PURPOSE: Irrigation
(home, irrigation, municipal, industrial)

WELL COMPLETION DATA:

(1) diameter (inches) 4 1/2"

(2) total depth (feet) 96'

(3) static water level (feet) 68' below top of ground.

(4) casing plastic bottom
(material) (depth)

(size) if telescope see back.

(5) screen 5' 91'
(length) (depth to top)


4" plastic
(size) (material)

(6) pump 1/2 sub 10
(HP) (yield gpm)

elec
(type power)

(7) electric log no
(yes or no)

(organization running log)

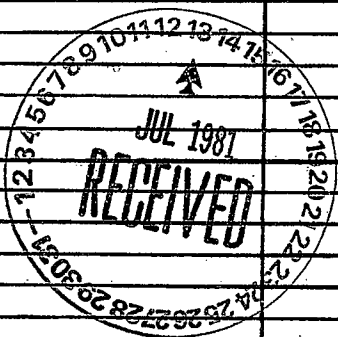

(8) how well bottom plugged Backwash valve

DRILLERS REMARKS:

If well telescopes please sketch and show depths.

GROUND LEVEL

X			

SECTION _____

Please indicate well location X.

ADDITIONAL INFORMATION

If more than one screen,
show locations of each on sketch.