

MISSISSIPPI DEPARTMENT OF NATURAL RESOURCES

Bureau of Land and Water Resources

Southport Mall

P.O. Box 10631

Jackson, Mississippi 39209

WATER WELL DRILLERS LOG

Pko
H 2001
12-17-80
Dec 17
1980 date well completed

Acme Well Service firm name
Pike county well located

LANDOWNER:
James L. Martin
Rt Magnolia
 (mailing address)

description of formations encountered

from

to

WELL LOCATION:


sec. 25 T 2 N R 8 E
6 1/2 miles E-SE of Magnolia
 (distance) (direction) (nearest town)

<u>Red Clay</u>	<u>0</u>	<u>17</u>
<u>Red sand</u>	<u>17</u>	<u>74</u>
<u>Gravelly sand</u>	<u>74</u>	<u>90</u>
<u>pink Chalk</u>	<u>90</u>	<u>92</u>
<u>Sandy sand</u>	<u>92</u>	<u>112</u>
<u>Gravelly sand</u>	<u>112</u>	<u>173</u>

WELL PURPOSE: house
 (home, irrigation, municipal, industrial)

WELL COMPLETION DATA:

- (1) diameter (inches) 4"
- (2) total depth (feet) 123
- (3) static water level (feet) 101 below top of ground.
- (4) casing plastic bottom
 (material) (depth)
- if telescope see back.
 (size)
- (5) screen 5' 118'
 (length) (depth to top)
- 4" plastic
 (size) (material)
- (6) pump 1/2 10
 (HP) (yield gpm)
- electric
 (type power)
- (7) electric log no
 (yes or no)
- (organization running log)

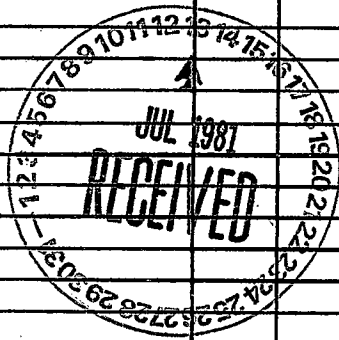


(8) how well bottom plugged back work - valve

DRILLERS REMARKS:

If well telescopes please
sketch and show depths.

GROUND LEVEL

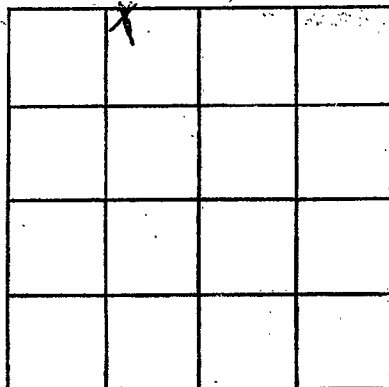

SECTION 25

Please indicate well location X.

ADDITIONAL INFORMATION

If more than one screen,
show locations of each on sketch.