

MISSISSIPPI DEPARTMENT OF NATURAL RESOURCES

Bureau of Land and Water Resources

Southport Mall

P.O. Box 10631

Jackson, Mississippi 39209

WATER WELL DRILLERS LOG

Pike
H 2022
2-7-81

Feb 7 1981
date well completed

1981 Premier Well Inc
firm name

Pike
county well located

LANDOWNER:	description of formations encountered	from	to
Price Magee Jr P.O. Magnolia (mailing address)	Clay Red sand Pink Gault & babbly Gravel & sand	0 16 50	16 50 95
WELL LOCATION: sec. 19 T 2 N R 8 E 2 miles S-SE of Magnolia (distance) (direction) (nearest town)			
WELL PURPOSE: house (home, irrigation, municipal, industrial)			
WELL COMPLETION DATA:			
(1) diameter (inches) 4"			
(2) total depth (feet) 105'			
(3) static water level (feet) 75' below top of ground.			
(4) casing plastic Centern (material) (depth)			
if telescope see back. (size)			
(5) screen 5' 100' (length) (depth to top)			
(6) pump 4" plastic (size) (material)			
(7) pump 1/2 HP 10 (HP) (yield gpm)			
(8) electric log (type power)			
(9) electric log no (yes or no)			
(10) (organization running log)			
(11) how well bottom plugged Backwash			
DRILLERS REMARKS:			


DEPT. OF NATURAL RESOURCES
BUREAU OF LAND & WATER RESOURCES

JUL 27 1981

RECEIVED

If well telescopes please sketch and show depths.

GROUND LEVEL

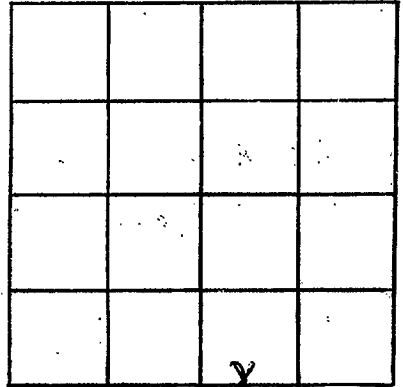

SECTION 19

Please indicate well location X.

ADDITIONAL INFORMATION

If more than one screen,
show locations of each on sketch.