

Phelps

MISSISSIPPI
BOARD OF WATER COMMISSIONERS
416 North State Street
Jackson, Mississippi 39201

WATER WELL DRILLERS LOG

PIKE
H 2023
5/26/81
5-626-81

date well completed

Amite Pump & Well Supply
firm name
Amite, La

Franklin
county well located

LANDOWNER:

description of formations encountered

from

to

Billy Ray Phelps
Rt 4 B 189 Magnolia, Mo.
(mailing address)

CLAY	0	17'
SAND	17'	20'
GRAVEL & SAND	20'	40'
GRAVEL	40'	50'
CLAY	50'	60'
CLAY	60'	70'
SAND & GRAVEL	70'	80'
SAND & GRAVEL	80'	100'
SAND & GRAVEL	100'	120'

WELL LOCATION:

sec. 3 T. 2(N) R. 8(E)
S W
5 miles E of Magnolia
(distance) (direction) (nearest town)


WELL PURPOSE:

Home
(home, irrigation, municipal, industrial)

WELL COMPLETION DATA:


- (1) diameter (inches) 4"
- (2) total depth (feet) 120'
- (3) static water level (feet) 65 below above top of ground.
- (4) casing PVC 110' (material) (depth)
(size) if telescope see back.
- (5) screen 10' 10' (length) (depth to top)
4" PVC (size) (material)
- (6) pump (HP) (yield gpm)
(type power)
- (7) electric log (yes or no)
(organization running log)
- (8) how well bottom plugged back - wash valve

DRILLERS REMARKS:

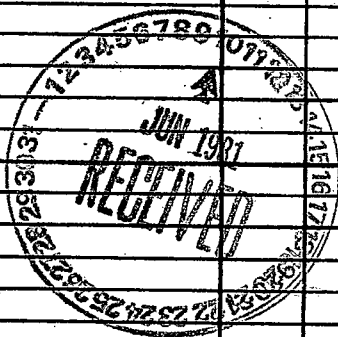

If well telescopes please sketch and show depths.

GROUND LEVEL

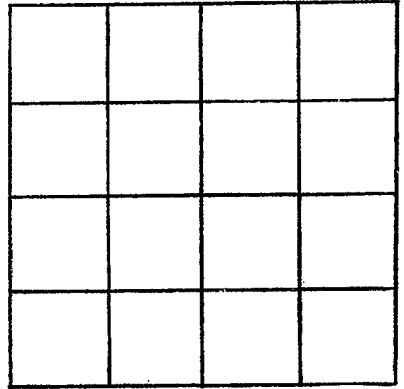

SECTION _____

Please indicate well location X.

ADDITIONAL INFORMATION

If more than one screen, show locations of each on sketch.