

Parker

3

PIKE
H 2024
6/3/81
1613-
date well completed

MISSISSIPPI
 BOARD OF WATER COMMISSIONERS
 416 North State Street
 Jackson, Mississippi 39201

WATER WELL DRILLERS LOG

1981 White Pump & Well Serv.
 firm name White La.

Parker Parish
 county well located

LANDOWNER: G.L. PARKER
RT1 B 180 B.
Magnolia, Ms. 39652
 (mailing address)

WELL LOCATION:
 sec. 28 T. 2 (N) R. 8 (E)
 S W
5 miles SE of MAZ.
 (distance) (direction) (nearest town)

description of formations encountered	depth	
	from	to
CLAY	0	20
CLAY	20	40
SMALL GRAVEL	40	50
Big GRAVEL	50	60
Big GRAVEL	60	80
Big GRAVEL	80	100

WELL PURPOSE:
 (home, irrigation, municipal, industrial)

WELL COMPLETION DATA:

(1) diameter (inches) 4"

(2) total depth (feet) 100'

(3) static water level (feet) 55' below above top of ground.

(4) casing 4" 90'
 (material) (depth)
 (size) if telescope see back.


(5) screen 10' PVC
 (length) (depth to top)
4" (material)
 (size)

(6) pump _____ (HP) _____ (yield gpm)
 (type power)

(7) electric log No
 (yes or no)

(organization running log)


(8) how well bottom plugged Back
Wash Valve

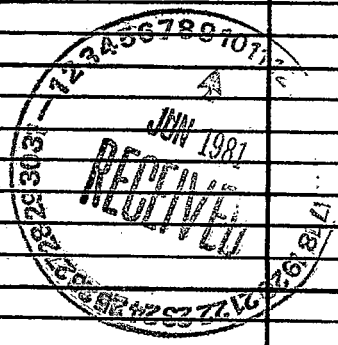

DRILLERS REMARKS:

If well telescopes please sketch and show depths.

GROUND LEVEL

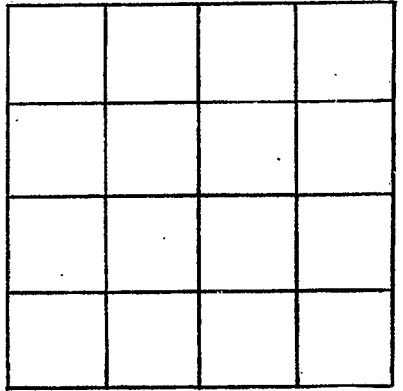

SECTION _____

Please indicate well location X.

ADDITIONAL INFORMATION

If more than one screen, show locations of each on sketch.