

PIKE
H
2007

MISSISSIPPI
BOARD OF WATER COMMISSIONERS
416 North State Street
Jackson, Mississippi 39201

WATER WELL DRILLERS LOG

6-15 1982 *P. H. Smallwell Inc* *Pike*
date well completed firm name county well located

LANDOWNER:
Jerry Reed
R.B. Mearns
(mailing address)

description of formations encountered	from	to
<i>Red Clay</i>	<i>0</i>	<i>20</i>
<i>Pool Sand</i>	<i>20</i>	<i>140</i>
<i>Coarse Sandstone</i>	<i>140</i>	<i>154</i>

WELL LOCATION:
sec. *33* T *2* N R *8* E
S W
6 miles *E* of *Mearns*
(distance) (direction) (nearest town)

WELL PURPOSE: *Home*
(home, irrigation, municipal, industrial)

- WELL COMPLETION DATA:
- (1) diameter (inches) *4*
 - (2) total depth (feet) *154*
 - (3) static water level (feet) *75* below above top of ground.
 - (4) casing *PVC*, *146*,
(material) (depth)
4 if telescope see back.
(size)
 - (5) screen *8*, *146*
(length) (depth to top)
4, *PVC*
(size) (material)
 - (6) pump *1/2*, *10*
(HP) (yield gpm)
elec
(type power)
 - (7) electric log *No*
(yes or no)
 - (8) how well bottom plugged *Sand Plug*


DRILLERS REMARKS:

DEPT. OF NATURAL RESOURCES
BUREAU OF LAND & WATER RESOURCES
JUL - 7 1982

RECEIVED

If well telescopes please sketch and show depths.

GROUND LEVEL

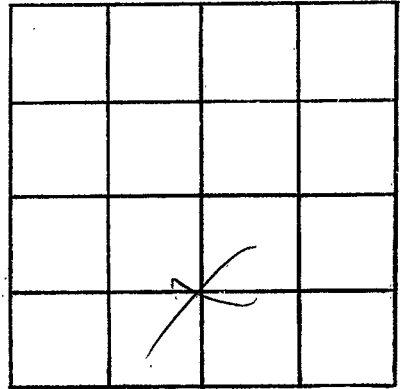

SECTION 33

Please indicate well location X.

ADDITIONAL INFORMATION

If more than one screen, show locations of each on sketch.