

**MISSISSIPPI DEPARTMENT OF NATURAL RESOURCES**  
**Bureau of Land and Water Resources**  
 Southport Mall  
 P.O. Box 10631  
 Jackson, Mississippi 39209  
**WATER WELL DRILLERS LOG**

<b>PIKE</b>
<b>H</b>
<b>2030</b>

1-17 1983 Fitzgerald well Pike  
 date well completed firm name county well located

**LANDOWNER:**  
Albert Smith  
R.R. Magnolia Mo.  
 (mailing address)

description of formations encountered	depth	
	from	to
<u>Red clay</u>	<u>0</u>	<u>20</u>
<u>Red sand</u>	<u>20</u>	<u>60</u>
<u>Coarse sand &amp; gravel</u>	<u>60</u>	<u>106</u>

**WELL LOCATION:**  
 sec. 18 T 2 N R 8 E  
                   S                    W  
1 miles E of Magnolia  
 (distance) (direction) (nearest town)

**WELL PURPOSE:** Home  
 (home, irrigation, municipal, industrial)

- WELL COMPLETION DATA:**
- (1) diameter (inches) 4
  - (2) total depth (feet) 106
  - (3) static water level (feet) 60 below above top of ground.
  - (4) casing PVC, 98  
 (material) (depth)  
4 if telescope see back.  
 (size)
  - (5) screen 8, 98  
 (length) (depth to top)  
4, PVC  
 (size) (material)
  - (6) pump 1/2, 10  
 (HP) (yield gpm)  
Electric  
 (type power)
  - (7) electric log No  
 (yes or no)  
 (organization running log)
  - (8) how well bottom plugged Sand pack

**DRILLERS REMARKS:**


DEPT. OF NATURAL RESOURCES  
 BUREAU OF LAND & WATER RESOURCES

MAR - 2 1983

**RECEIVED**

If well telescopes please sketch and show depths.

GROUND LEVEL

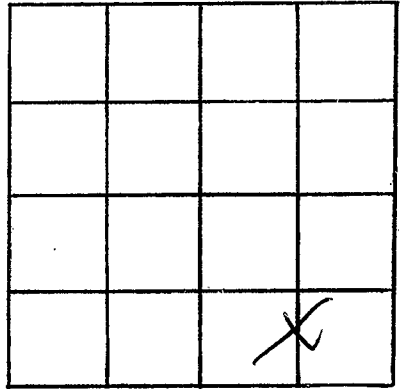

SECTION 18

Please indicate well location X.

ADDITIONAL INFORMATION

If more than one screen,  
show locations of each on sketch.