

Pike  
H  
2031

MISSISSIPPI DEPARTMENT OF NATURAL RESOURCES  
 Bureau of Land and Water Resources  
 Southport Mall  
 P.O. Box 10631  
 Jackson, Mississippi 39209  
**WATER WELL DRILLERS LOG**

3-28 1983 Hawthornwell Service Pike  
 date well completed firm name county well located

LANDOWNER:	description of formations encountered	from	to
<u>Cecaldine Burch</u>			
<u>R.R. Magnolia</u> (mailing address)	<u>Red Clay</u>	<u>0</u>	<u>20</u>
	<u>Red Sand</u>	<u>20</u>	<u>100</u>
	<u>Coarse Sand &amp; gravel</u>	<u>100</u>	<u>120</u>
WELL LOCATION:			
sec. <u>22</u> T. <u>2</u> N R. <u>8</u> E S W			
<u>6</u> miles <u>E</u> of <u>Magnolia</u> (distance) (direction) (nearest town)			
WELL PURPOSE: (home, irrigation, municipal, industrial)			
<u>Home</u>			
WELL COMPLETION DATA:			
(1) diameter (inches) <u>4</u>			
(2) total depth (feet) <u>120</u>			
(3) static water level (feet) <u>55</u> below above top of ground.			
(4) casing <u>PVC</u> , <u>112</u> , (material) (depth) <u>4</u> If telescope see back. (size)			
(5) screen <u>8</u> , <u>112</u> (length) (depth to top) <u>1/4</u> , <u>PVC</u> (size) (material)			
(6) pump <u>1/2</u> <u>10</u> (HP) (yield gpm) <u>Electric</u> (type power)			
(7) electric log <u>no</u> (yes or no) <u>(organization running log)</u>			
(8) how well bottom plugged <u>Steel Plug</u>			

DEPT. OF NATURAL RESOURCES  
 BUREAU OF LAND & WATER RESOURCES


MAY 9 1993

RECEIVED

DRILLERS REMARKS:

If well telescopes please sketch and show depths.

GROUND LEVEL

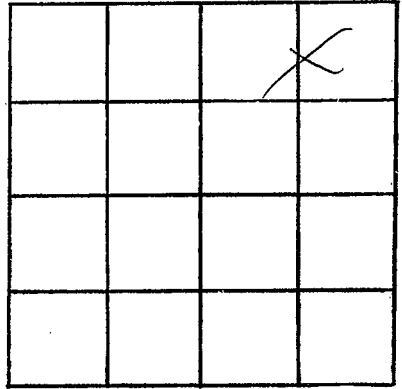

SECTION 22

Please indicate well location X.

ADDITIONAL INFORMATION

If more than one screen,  
show locations of each on sketch.