

MISSISSIPPI DEPARTMENT OF NATURAL RESOURCES

Bureau of Land and Water Resources

Southport Mall

P.O. Box 10631

Jackson, Mississippi 39209

WATER WELL DRILLERS LOG

Pike
H 2036
6-28-85

L

6-28 1984
date well completed

Fitzgerald Well Sew
firm name

Pike
county well located

LANDOWNER:	description of formations encountered	from	to
Simela Hurst -			
R.R. Magnolia ms. (mailing address)	Red clay Red sand Coarse sand & gravel	0 20 110	20 110 126
WELL LOCATION:			
sec. <u>5</u> T <u>2</u> N R <u>8</u> E S W			
<u>3</u> miles <u>NE</u> of <u>Magnolia</u> (distance) (direction) (nearest town)			
WELL PURPOSE: (home, irrigation, municipal, industrial)			
WELL COMPLETION DATA:			
(1) diameter (inches) <u>4</u>			
(2) total depth (feet) <u>126</u>			
(3) static water level (feet) <u>50</u> below above top of ground.			
(4) casing <u>PVC</u> <u>116</u> (material) (depth) <u>4</u> if telescope see back. (size)			
(5) screen <u>10</u> <u>116</u> (length) (depth to top) <u>4</u> <u>PVC</u> (size) (material)			
(6) pump <u>1/2</u> <u>10</u> (HP) (yield gpm) <u>Elc</u> (type power)			
(7) electric log <u>no</u> (yes or no)			
(organization running log)			
(8) how well bottom plugged <u>Sand plug</u>			
DRILLERS REMARKS:			


RECEIVED

JUL 29 1985

Natural Resources
Water Resources

If well telescopes please sketch and show depths.

GROUND LEVEL

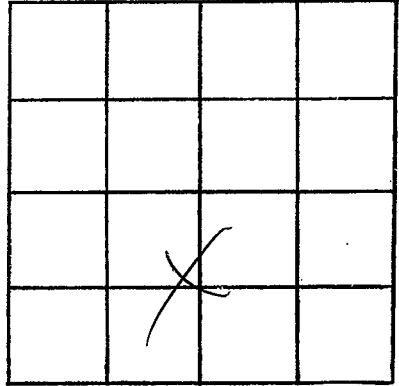

SECTION 5

Please indicate well location X.

ADDITIONAL INFORMATION

If more than one screen,
show locations of each on sketch.