

MISSISSIPPI DEPARTMENT OF NATURAL RESOURCES

Bureau of Land and Water Resources

Southport Mall

P.O. Box 10631

Jackson, Mississippi 39209

WATER WELL DRILLERS LOG

L

Pike  
H 2037  
6-6-85

6-6 1985 Flycatcher Well Sew Pike  
date well completed firm name county well located

LANDOWNER:  
John Marshall  
R.R. Magnolia, ms.  
(mailing address)

| description of formations encountered | from       | to         |
|---------------------------------------|------------|------------|
| <u>Red Clay</u>                       | <u>0</u>   | <u>20</u>  |
| <u>Red sand</u>                       | <u>20</u>  | <u>110</u> |
| <u>Coarse sand &amp; gravel</u>       | <u>110</u> | <u>126</u> |

WELL LOCATION:  
sec. 23 T 2 N R 8 E  
S W  
8 miles E of Magnolia  
(distance) (direction) (nearest town)

WELL PURPOSE: Home  
(home, irrigation, municipal, industrial)

- WELL COMPLETION DATA:
- (1) diameter (inches) 4
  - (2) total depth (feet) 126
  - (3) static water level (feet) 80 below above top of ground.
  - (4) casing PVC, 116  
(material) (depth)  
4 if telescope see back.  
(size)
  - (5) screen 10, 116  
(length) (depth to top)  
4, PVC  
(size) (material)
  - (6) pump 1/2, 10  
(HP) (yield gpm)  
Electric  
(type power)
  - (7) electric log No  
(yes or no)  
(organization running log)
  - (8) how well bottom plugged Sand plug

RECEIVED


JUL 22 1985

DRILLERS REMARKS:

Department of Natural Resources  
Bureau of Land & Water Resources

If well telescopes please sketch and show depths.

GROUND LEVEL

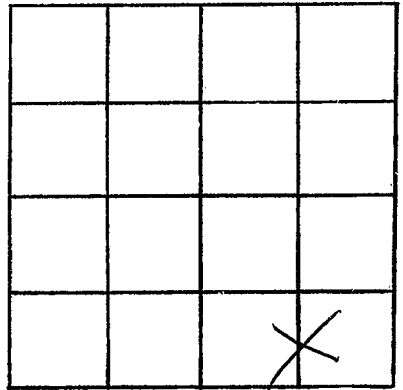

SECTION 23

Please indicate well location X.

ADDITIONAL INFORMATION

If more than one screen,  
show locations of each on sketch.