

MISSISSIPPI DEPARTMENT OF NATURAL RESOURCES
 Bureau of Land and Water Resources
 Southport Mall
 P.O. Box 10631
 Jackson, Mississippi 39209
WATER WELL DRILLERS LOG

Dike
H 2035


9-16 1985 Fitzgerald well for Dike
 date well completed firm name county well located

LANDOWNER: Mr. H.C. Rebald
R.P. Marmalin Mrs.
 (mailing address)
 WELL LOCATION:
 sec. 11 T. 2 N S R. 8 E W
7 miles E of MASTICULA
 (distance) (direction) (nearest town)
 WELL PURPOSE: Home
 (home, irrigation, municipal, industrial)

description of formations encountered	depth	
	from	to
<u>Red clay</u>	<u>0</u>	<u>20</u>
<u>Red sand</u>	<u>20</u>	<u>80</u>
<u>Red gravel</u>	<u>80</u>	<u>130</u>
<u>Red sand</u>	<u>130</u>	<u>140</u>
<u>Coarse sand/gravel</u>	<u>140</u>	<u>152</u>

WELL COMPLETION DATA:
 (1) diameter (inches) 4
 (2) total depth (feet) 152
 (3) static water level (feet) 95 below/above top of ground.
 (4) casing PVC, 142,
 (material) (depth)
4 if telescope see back.
 (size)
 (5) screen 10, 142
 (length) (depth to top)
4, PVC
 (size) (material)
 (6) pump 1/2 10
 (HP) (yield gpm)
elec
 (type power)
 (7) electric log no
 (yes or no)

 (organization running log)
 (8) how well bottom plugged Sand blk

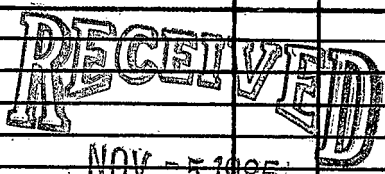


NOV - 5 1985

DRILLERS REMARKS:

Department of Natural Resources
 Bureau of Land & Water Resources

If well telescopes please
sketch and show depths.

GROUND LEVEL

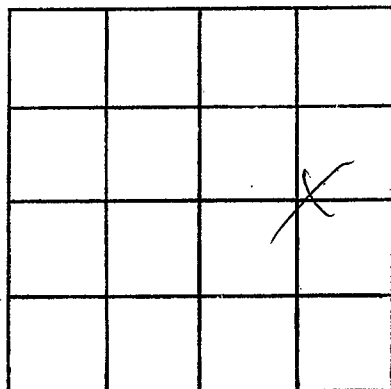

SECTION 11

Please indicate well location X.

ADDITIONAL INFORMATION

If more than one screen,
show locations of each on sketch.