

MISSISSIPPI DEPARTMENT OF NATURAL RESOURCES
 Bureau of Land and Water Resources
 Southport Mall
 P.O. Box 10631
 Jackson, Mississippi 39209
WATER WELL DRILLERS LOG

PIKE
H205

date well completed May 23 1985 Stafford Natural Well firm name Pike county well located

LANDOWNER: Albert Simmons

description of formations encountered

from to

Rt 4
 Magnolia, Ms 39652
 (mailing address)

~~Red top soil~~
 chalk

0 1'
 1' 50'

WELL LOCATION:

sec. 34 T. 2 N. R. 8 E.
 S. W.
8 miles S.E. of Magnolia
 (distance) (direction) (nearest town)

gravel
 red chalk

50' 65'
 65' 67'

WELL PURPOSE: Home
 (home, irrigation, municipal, industrial)

sand & gravel
 red chalk

67' 105'
 105' 140'

WELL COMPLETION DATA:

- (1) diameter (inches) 7 1/2"
- (2) total depth (feet) 170'
- (3) static water level (feet) 120 ~~above~~ below top of ground.
- (4) casing plastic 170
 (material) (depth)
 (size) if telescope see back.
- (5) screen 10' 160'
 (length) (depth to top)
4" plastic
 (size) (material)
- (6) pump 1/2 11
 (HP) (yield gpm)
electric
 (type power)
- (7) electric log
 (yes or no)

 (organization running log)
- (8) how well bottom plugged
sand shank

water sand & gravel 140' 170'

RECEIVED
 JUN 23 1985


Department of Natural Resources
 Bureau of Land & Water Resources

DRILLERS REMARKS:

Well Done as stated
by Ernie Stafford

If well telescopes please sketch and show depths.

GROUND LEVEL

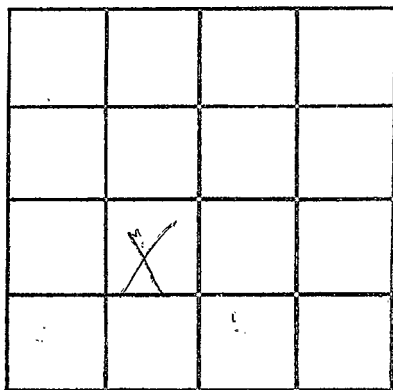

SECTION 341

Please indicate well location X.

ADDITIONAL INFORMATION

If more than one screen, show locations of each on sketch.