

MISSISSIPPI DEPARTMENT OF NATURAL RESOURCES

Bureau of Land and Water Resources

Southport Mall

P.O. Box 10631

Jackson, Mississippi 39209

WATER WELL DRILLERS LOG

PIKE
H
2040


6-2 1986 date well completed 86 Stafford Water Well firm name PIKE county well located

LANDOWNER: <u>ER. Mallette</u>	description of formations encountered	from	to
<u>Rt 3</u>			
<u>Magnolia, Ms 39652</u> (mailing address)	<u>Red clay</u>	<u>6"</u>	<u>10'</u>
WELL LOCATION: sec. <u>15 T 2 N</u> R. <u>8 E</u> S W	<u>Red clay &amp; gravel</u>	<u>10'</u>	<u>45'</u>
<u>6</u> miles <u>east</u> of <u>Magnolia</u> (distance) (direction) (nearest town)	<u>pink clay</u>	<u>45'</u>	<u>65'</u>
WELL PURPOSE: <u>none</u> (home, irrigation, municipal, industrial)	<u>course sand &amp; gravel</u>	<u>65'</u>	<u>105'</u>
WELL COMPLETION DATA:	<u>Red clay</u>	<u>105'</u>	<u>115'</u>
(1) diameter (inches) <u>4"</u>	<u>course sand &amp; gravel</u>	<u>115'</u>	<u>160'</u>
(2) total depth (feet) <u>160'</u>			
(3) static water level (feet) <u>73</u> <sup>below</sup> / <sub>above</sub> top of ground.			
(4) casing <u>plastic, 160'</u> (material) (depth)			
(size) if telescope see back.			
(5) screen <u>10'</u> <u>150'</u> (length) (depth to top)			
(size) <u>4"</u> <u>plastic</u> (material)			
(6) pump <u>1/2</u> <u>11</u> (HP) (yield gpm)			
(type power) <u>electric</u>			
(7) electric log (yes or no) _____			
(organization running log) _____			
(8) how well bottom plugged <u>sand spark</u>			
DRILLERS REMARKS:			

RECEIVED  
JUN 10 1986

If well telescopes please sketch and show depths.

GROUND LEVEL

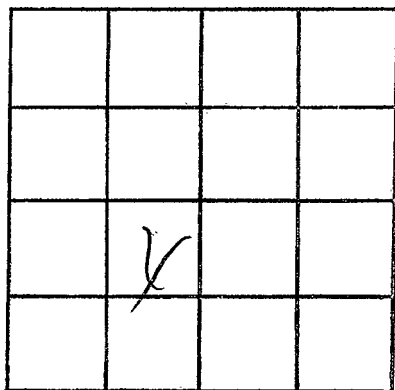

SECTION 15

Please indicate well location X.

ADDITIONAL INFORMATION

If more than one screen,  
show locations of each on sketch.