

MISSISSIPPI DEPARTMENT OF NATURAL RESOURCES

Bureau of Land and Water Resources

Southport Mall

P.O. Box 10631

Jackson, Mississippi 39209

WATER WELL DRILLERS LOG

PIKE  
H 2042

9-9 1986  
date well completed

86 Fitzgerald Well Serv  
firm name

Pike  
county well located

LANDOWNER:

Charles Smith

R.R. Magnolia Ms.  
(mailing address)

description of formations encountered

from

to

Rigid clay 0 20  
Red sand 20 86  
Coarse sand & gravel 86 101

WELL LOCATION:

sec. 14 T 2 N R 8 E  
S W  
5 miles E of Magnolia  
(distance) (direction) (nearest town)

WELL PURPOSE:

Home  
(home, irrigation, municipal, industrial)

WELL COMPLETION DATA:

- (1) diameter (inches) 4
- (2) total depth (feet) 101
- (3) static water level (feet) 53 below top of ground.
- (4) casing PVC 91, (material) (depth)  
4 (size) if telescope see back.
- (5) screen 10 91 (length) (depth to top)  
4 (size) PVC (material)
- (6) pump 1/2 10 (HP) (yield gpm)  
Elex (type power)
- (7) electric log No (yes or no)  
(organization running log)
- (8) how well bottom plugged Sand Shrub




OCT 14 1986

Department of Natural Resources  
Bureau of Land & Water Resources

DRILLERS REMARKS:

If well telescopes please sketch and show depths.

GROUND LEVEL

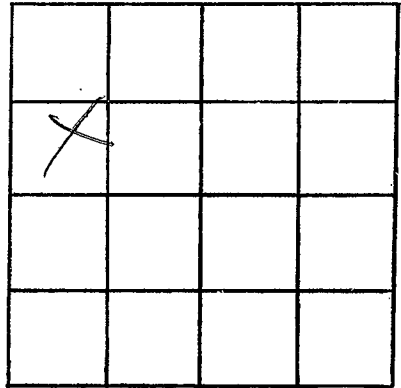

SECTION 14

Please indicate well location X.

ADDITIONAL INFORMATION

If more than one screen,  
show locations of each on sketch.