

MISSISSIPPI DEPARTMENT OF NATURAL RESOURCES

Bureau of Land and Water Resources

Southport Mall

P.O. Box 10631

Jackson, Mississippi 39209

WATER WELL DRILLERS LOG

Pike
H 2045

7-20 1987 Filgore Well Serv Pike
date well completed firm name county well located


LANDOWNER:	description of formations encountered	from	to
<u>Larry Reed</u>	<u>Reel clay</u>	<u>0</u>	<u>20</u>
<u>R.R. Magnolia Mrs.</u> (mailing address)	<u>Reel sand</u>	<u>20</u>	<u>136</u>
WELL LOCATION: sec. <u>33</u> T- <u>2</u> N R- <u>8</u> E S W	<u>Coarse sand & gravel</u>	<u>136</u>	<u>150</u>
<u>8</u> miles <u>E</u> of <u>Magnolia</u> (distance) (direction) (nearest town)			
WELL PURPOSE: <u>Home</u> (home, irrigation, municipal, industrial)			
WELL COMPLETION DATA:			
(1) diameter (inches) <u>4</u>			
(2) total depth (feet) <u>150</u>			
(3) static water level (feet) <u>66</u> below above top of ground.			
(4) casing <u>PVC</u> , <u>140</u> (material) (depth)			
<u>4</u> if telescope see back. (size)			
(5) screen <u>10</u> , <u>140</u> (length) (depth to top)			
<u>4</u> , <u>PVC</u> (size) (material)			
(6) pump <u>1/2</u> , <u>10</u> (HP) (yield gpm)			
<u>Ele</u> (type power)			
(7) electric log <u>No</u> (yes or no)			
(organization running log)			
(8) how well bottom plugged <u>Sand plug</u>			
DRILLERS REMARKS:			

RECEIVED
JUL 27 1987

Department of Natural Resources
Bureau of Land & Water Resources

If well telescopes please sketch and show depths.

GROUND LEVEL

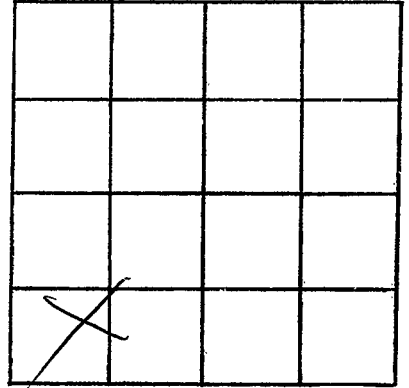

SECTION 33

Please indicate well location X.

ADDITIONAL INFORMATION

If more than one screen,
show locations of each on sketch.