

PIKE  
H 2050

MISSISSIPPI DEPARTMENT OF NATURAL RESOURCES  
Bureau of Land and Water Resources  
Southport Mall  
P.O. Box 10631  
Jackson, Mississippi 39209  
WATER WELL DRILLERS LOG

Aug 30 1990 Fitzgerald Well Serv Pike  
date well completed firm name county well located

LANDOWNER:  
John Reeking  
R.R. Magnolia ms.  
(mailing address)

description of formations encountered	from	to
<u>Red clay</u>	<u>0</u>	<u>20</u>
<u>Red sand</u>	<u>20</u>	<u>75</u>
<u>Coarse sand &amp; gravel</u>	<u>75</u>	<u>100</u>

WELL LOCATION:  
sec. 22 T 2 N R 8 E  
S W  
7 miles E of Magnolia  
(distance) (direction) (nearest town)

WELL PURPOSE: Home  
(home, irrigation, municipal, industrial)

- WELL COMPLETION DATA:
- (1) diameter (inches) 4
  - (2) total depth (feet) 100
  - (3) static water level (feet) 45 below top of ground.
  - (4) casing PVC / 90  
(material) / (depth)  
4 if telescope see back.  
(size)
  - (5) screen 10 / 90  
(length) / (depth to top)  
4 / PVC  
(size) / (material)
  - (6) pump 1/2 / 10  
(HP) / (yield gpm)  
Elco  
(type power)
  - (7) electric log no  
(yes or no)  
(organization running log)
  - (8) how well bottom plugged Sand blk


REGISTERED  
SEP 27 1990

Department of Natural Resources  
Bureau of Land & Water Resources

DRILLERS REMARKS:

If well telescopes please sketch and show depths.

GROUND LEVEL

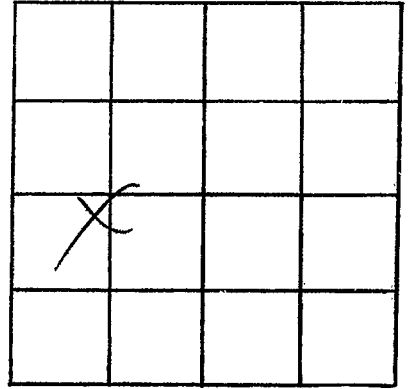

SECTION 22

Please indicate well location X.

ADDITIONAL INFORMATION

If more than one screen,  
show locations of each on sketch.