

MISSISSIPPI DEPARTMENT OF ENVIRONMENTAL QUALITY

Office of Land and Water Resources

P. O. Box 10631
Jackson, MS 39289-0631
WATER WELL DRILLERS LOG

COUNTY WELL LOCATED <i>Pike</i>	
WELL NUMBER <i>H</i>	CODED
DATE WELL COMPLETED <i>2056</i> <i>June 2-93</i>	

PERMIT NUMBER
NAME OF DRILLING FIRM <i>F. L. GERARD Well Serv</i>

NAME & MAILING ADDRESS OF LANDOWNER <i>JOHN WAYNE SIMMONS</i> <i>RR. MAGNOLIA MS</i>			
WELL LOCATION:	SEC <i>22</i>	TOWNSHIP <i>2</i>	RANGE <i>8</i>
		<i>N</i>	<i>E</i>
		<i>S</i>	<i>W</i>
DISTANCE <i>1/2</i> Miles	DIRECTION <i>EAST</i>	NEAREST TOWN <i>MAGNOLIA</i>	
OTHER LANDMARK			
WELL PURPOSE: Home, Irrigation, Municipal, Industrial, Fish Pond, etc. <i>CH. CREEK HOUSE</i>			

PUMP DATA		
PUMP TYPE (Circle One): Submersible , Turbine, Jet, Flowing Well, Other (Describe)		
POWER TYPE (Circle One): Electric , Tractor, Diesel, Gasoline, Butane, Other (Describe) <i>H/P</i>		
Pump Capacity (GPM) <i>20</i>	No. of Stages <i>10</i>	Setting Depth <i>80</i> FT.
PUMP TEST		
Well yielded <i>50</i> GPM with a drawdown of <i>1</i> ft. after <i>1</i> hours of pumping		

WELL DATA		
Well Depth <i>100</i>	Casing Diameter (In.) <i>4</i>	Casing Length (Ft.) <i>90</i>
Type of Casing <i>N/C</i>	Hole-Depth <i>100</i>	Depth to Static Water Level <i>42</i>
TYPE OF COMPLETION: (Circle One or More): Gravel Packed , Underreamed, Telescoped, Natural Development , Open Hole, Other		
WELL GROUTED TO A DEPTH OF <i>10</i> FEET Type Grout (circle one): Cement, Bentonite, <u><i>or Mix</i></u>		

LOG DATA	
TYPE OF LOG RUN (Circle One): Electric, Gamma Ray, Density, Sonic, <u><i>No Log Run</i></u> , Neutron, Other (Describe)	
Name of Organization Running Log	

SCREEN DATA		
Diameter - Inches <i>4</i>	Length - Feet <i>10</i>	Slot Size - Inches <i>1014</i>
Screen Type <i>N/C</i>	Depth to Bottom - Feet <i>100</i>	


GEOLOGIC DATA (Office Use Only)			
Surface Elev.	Geologic Unit	Unit Thickness	Depth to Top
Subs. SWL	Date	Analysis	Aquifer Test
Driller's Remarks			

DESCRIPTION OF FORMATIONS ENCOUNTERED	FROM	TO	FORMATIONS (Continued)	FROM	TO
<i>Red Clay</i>	<i>0</i>	<i>10</i>	RECEIVED JUN 29 1993 Dept. of Environmental Quality Office of Land & Water Resources		
<i>Red Sand</i>	<i>10</i>	<i>70</i>			
<i>Coarse Sand</i>	<i>70</i>	<i>100</i>			

IF MORE SPACE IS NEEDED, USE BACK

If well telescopes please sketch and show depths.

GROUND LEVEL

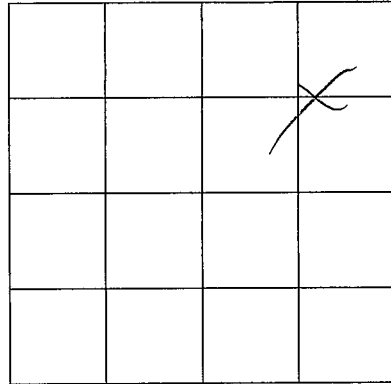

SECTION 22

Please indicate well location X.

ADDITIONAL INFORMATION

If more than one screen,
show location of each on sketch.