

**MISSISSIPPI DEPARTMENT OF ENVIRONMENTAL
QUALITY**

Office of Land and Water Resources

P. O. Box 10631
Jackson, MS 39289-0631
WATER WELL DRILLERS LOG

COUNTY WELL LOCATED PIKE	
WELL NUMBER H-2083	CODED
DATE WELL COMPLETED 9-22-99	

PERMIT NUMBER 0-287
NAME OF DRILLING FIRM REEVES WELL SER.

NAME & MAILING ADDRESS OF LANDOWNER WALLACE ROSS		
1090 ALLEN LANE		
MAGNOLIA MISS		
WELL LOCATION: SEC	TOWNSHIP	RANGE
32	2	8
DISTANCE	DIRECTION	NEAREST TOWN
4 Miles	S	of MAGNOLIA
OTHER LANDMARK		
WELL PURPOSE: <input checked="" type="checkbox"/> Home, <input type="checkbox"/> Irrigation, <input type="checkbox"/> Municipal, <input type="checkbox"/> Industrial, <input type="checkbox"/> Fish Pond, etc.		

PUMP DATA		
PUMP TYPE (Circle One): Submersible, Turbine, Jet, Flowing Well, Other (Describe) _____		
POWER TYPE (Circle One): <input checked="" type="checkbox"/> Electric, Tractor, Diesel, Gasoline, <input checked="" type="checkbox"/> Butane. Other (Describe) _____ H/P 1/2		
Pump Capacity (GPM) 10	No. of Stages 8	Setting Depth 120 FT.
PUMP TEST		
Well yielded 50 GPM with a drawdown of 0 ft. after 1 hours of pumping		

WELL DATA		
Well Depth 130'	Casing Diameter (In.) 4"	Casing Length (Ft.) 20'
Type of Casing PVC	Hole Depth 130'	Depth to Static Water Level 90'
TYPE OF COMPLETION: (Circle One or More): Gravel Packed, Underreamed, Telescoped, Natural Development, Open Hole, Other (Describe) 10 GAL. SAND		
WELL GROUTED TO A DEPTH OF 10 FEET Type Grout (circle one): <input checked="" type="checkbox"/> Cement, <input type="checkbox"/> Bentonite, or Mix		

LOG DATA	
TYPE OF LOG RUN (Circle One): No Log Run, Electric, Gamma Ray, Density, Sonic, Neutron, Other (Describe) _____	
Name of Organization Running Log	

SCREEN DATA		
Diameter - Inches 4"	Length - Feet 10'	Slot Size - Inches 105 Slot
Screen Type PVC	Depth to Bottom - Feet 130'	

GEOLOGIC DATA (Office Use Only)			
Surface Elev.	Geologic Unit	Unit Thickness	Depth to Top
Subs. SWL	Date	Analysis	Aquifer Test


Driller's Remarks REC'D JAN 03 2002
Top of Lap Pipe or Reduction in Casing FEET
IF TELESCOPED OR MORE THAN ONE SCREEN: USE BACK PAGE

DESCRIPTION OF FORMATIONS ENCOUNTERED	FROM	TO	FORMATIONS (Continued)		
			FROM	TO	
CLAY	0	15			
SAND & GRAVEL	15	80			
loosely SAND	80	100			
RED CHALK	100	110			
SAND & GRAVEL	110	130			

IF MORE SPACE IS NEEDED, USE BACK

If well telescopes please
sketch and show depths.

GROUND LEVEL

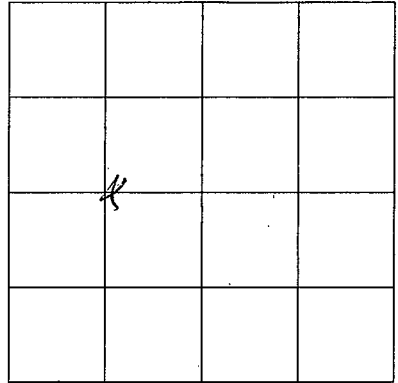

SECTION 32

Please indicate well location X.

ADDITIONAL INFORMATION

If more than one screen,
show location of each on sketch.