

PIKE

J1

CODED

WATER WELL DRILLERS LOG

J-300

Date: 8-20, 1960, Driller: W.J. Fitzgerald County Pike

(Name)

(1) Owner of Land: Hugh F Tate

(Name)

RT 2 McBomb Miss

(Address)

(2) Location: 1/4, 1/4, Sec. 10 T. 29 R. 9

12 miles E. & S. of McBomb

(distance)

(direction)

(Nearest Town)

(3) Topography: (Hilly) (Flat) (Level)

(4) Purpose of Well: Domestic

(Domestic Irrigation Municipal, Industrial, Other)

Description & Color of Materials Sand, Clay, Red Clay, Shell, etc.

Thick-ness Feet

Depth Feet

Top Soil + Clay	0	12
Fine Red Sand	12	30
White + Blue Shale	30	150
Fine Sand	150	165
Coarse Sand	165	182

Information upon completion of well:

(1) Diameter 2 inches.

(2) Total Depth 182 feet.

(3) Water Level 18 feet below top of ground.

(4) Cased to 178, Size 2"

(5) Screen: Size 1 1/4, Length 4 ft.

(6) Were any formations sealed against pollution?


yes, no. [checked]

If YES depth of formation

Why

Drillers Remarks:

CODED

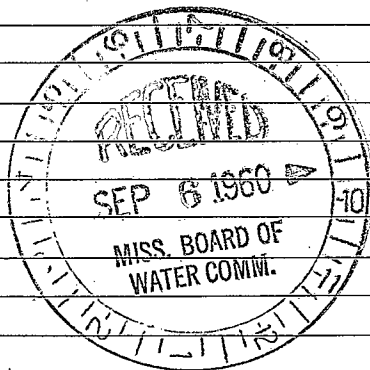

(Use Back Side)

2

Well No.

