

PIKE

J4

7-24-62

CODE 110

WATER WELL DRILLERS LOG

Date: 7-24, 1962, Driller: Chester Reeves County: Pike

(Name)

(1) Owner of Land: Prescott Sherman (Name)  
McComb (Address)

(2) Location: 1/4, 1/4, Sec. 2 T. 29 N., R. 12 E., of McComb (Nearest Town)  
12 miles EAST (distance) (direction)


(3) Topography: Flat (Hilly) (Flat) (Level)

(4) Purpose of Well: Camp (Domestic Irrigation, Municipal, Industrial, Other)

| Description & Color of Materials<br>Sand, Clay, Red Clay, Shell, etc. | Thick-<br>ness<br>Feet | Depth<br>Feet |
|---|------------------------|---------------|
| Sandy clay  | 10                     | 10            |
| Sandy gravel  | 8                      | 18            |
| Blue clay   | 100                    | 118           |
| fine sand   | 22                     | 140           |
| Coarse sand   | 25                     | 165           |

Information upon completion of well:

- (1) Diameter 2 inches.
- (2) Total Depth 165 feet.
- (3) Water Level artesian feet below top of ground.
- (4) Cased to bottom Size
- (5) Screen: Size 1/4" Length 6'
- (6) Were any formations sealed against pollution?  
yes, no.

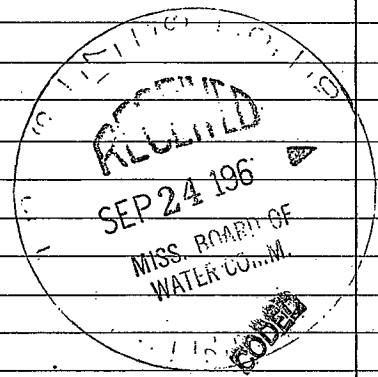

REEVES WELL AND PUMP CO. Phone 1250 McCOMB, MISSISSIPPI

If YES depth of formation

Why

Drillers Remarks: Camp site  
No previous well

Well No.

(Use Back Side)

1914

1915

1916

1917

1918

1919

1920