

PIKE

J5

3-25-65

MISSISSIPPI BOARD OF WATER COMMISSIONERS

WATER WELL DRILLERS LOG

Date: 3-25-65, 1965, Driller: Chester Reeves County, Pike (Name)

(1) Owner of Land: Lee Terrell (Name)
 RFD 1, Magnolia (Address)

(2) Location: 1/4, 1/4, Sec 32 T29R9, 11 miles East of Magnolia (direction), (Nearest Town)

(3) Topography: Hilly (Hilly), (Flat), (Level)

(4) Purpose of Well: Domestic (Domestic Irrigation, Municipal, Industrial, Other)

Description & Color of Materials Sand, Clay, Red Clay, Shell, etc.	Thick- ness Feet	Depth Feet
Red clay	35	35
Hard yellow sand & gravel	65	100
Small gravel & sand	20	120

Information upon completion of well:

(1) Diameter: 4 inches.

(2) Total Depth: 120 feet.

(3) Water Level: 97 feet below top of ground.

(4) Cased to Bottom, Size 4"

(5) Screen: Size 4", Length 7'

(6) Were any formations sealed against pollution?
 yes, no,


If YES depth of formation _____

Why _____

Drillers Remarks: Bad old well

CODED

REEVES WELL & PUMP CO. P. O. BOX 71 -- PHONE 684-1451

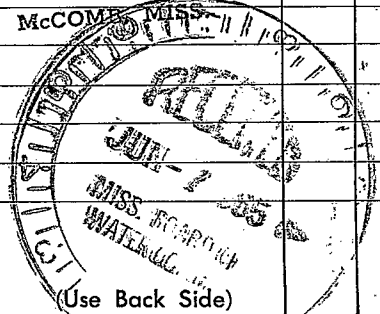

Well No.

