

CODED

Pike
Tb
1-67

MISSISSIPPI
BOARD OF WATER COMMISSIONERS
416 North State Street
Jackson, Mississippi 39201

WATER WELL DRILLERS LOG

1-3 1967 Fitzgerald Water Well Co. Pike
date well completed firm name county well located

LANDOWNER: Wood Williams

R2 McComb Miss

(mailing address)

WELL LOCATION:

sec. 7 T. 2 N. R. 9 E. S. 10 W.
10 miles ESE of McComb
(distance) (direction) (nearest town)

WELL PURPOSE: house
(home, irrigation, municipal, industrial)

WELL COMPLETION DATA:

(1) diameter (inches) 2

(2) total depth (feet) 136

(3) static water level (feet) 100 below above top of ground.

(4) casing Galv Pipe 132
(material) (depth)

2 if telescope see back.
(size)

(5) screen 4 132
(length) (depth to top)

1/4" Stainless steel
(size) (material)

(6) pump 1/2 HP 3
(HP) (yield gpm)

3 hp
(type power)

(7) electric log no
(yes or no)


(organization running log)

(8) how well bottom plugged Wood Peg

DRILLERS REMARKS:


description of formations encountered	from	to
Top Soil & Red Clay	0	20
Red Sand	45	65
Gravel & Sand	30	95
Sand	15	110
Chalk Red	10	120
Sand & gravel	16	136

CODED

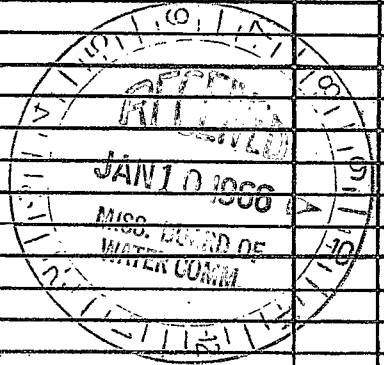

If well telescopes please sketch and show depths.

GROUND LEVEL

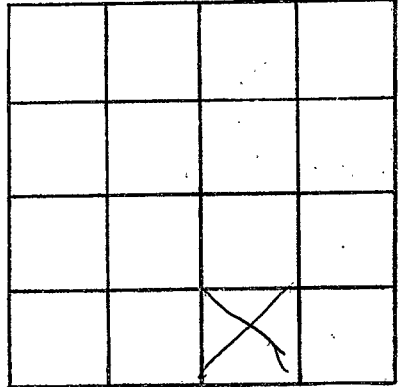

SECTION 7

Please indicate well location X.

ADDITIONAL INFORMATION

If more than one screen,
show locations of each on sketch.