

CODED

Pike
J7
8-67

MISSISSIPPI
BOARD OF WATER COMMISSIONERS
416 North State Street
Jackson, Mississippi 39201

WATER WELL DRILLERS LOG

Aug 1 67 Reeves Well Pump Co Pike
date well completed firm name county well located

LANDOWNER: #2 Steele

RFD
Magnolia
(mailing address)

WELL LOCATION:

sec 30 T 2 N R 9 E
8 miles SSE of Magnolia
(distance) (direction) (nearest town)

WELL PURPOSE: Home
(home, irrigation, municipal, industrial)

WELL COMPLETION DATA:

- (1) diameter (inches) 4"
- (2) total depth (feet) 120'
- (3) static water level (feet) 100' below top of ground.
- (4) casing Plastic Bottom
(material) (depth)
- (size) if telescope see back.
- (5) screen 6' length, 14' depth to top
4" Plastic
(size) (material)
- (6) pump 1/2 Sub 10
(HP) (yield gpm)
Direct
(type power)
- (7) electric log No
(yes or no)
- (organization running log)
- (8) how well bottom plugged Zircaloy plug

description of formations encountered

description of formations encountered	from	to
Red clay	0	20
Red sandy chalk	20	40
Red sand	40	60
sand & gravel	60	85
Red chalk	85	90
gravel & sand	90	102
chalk	102	107
Small gravel & sand	107	120

CODED




DRILLERS REMARKS:

House built
no other well

If well telescopes please sketch and show depths.

GROUND LEVEL

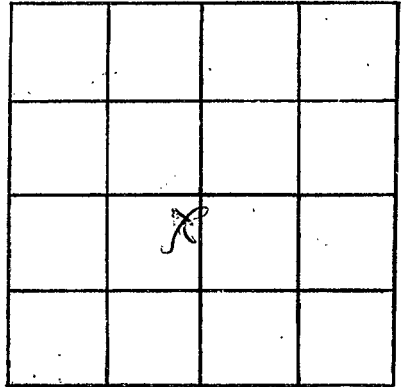

SECTION 30

Please indicate well location X.

ADDITIONAL INFORMATION

If more than one screen, show locations of each on sketch.