

CODED

MISSISSIPPI  
BOARD OF WATER COMMISSIONERS  
416 North State Street  
Jackson, Mississippi 39201

WATER WELL DRILLERS LOG

*Fitzgerald Well Service*  
~~C. L. Chambers~~

Pike  
J 8  
3-67

Mar 9  
date well completed

19 67

firm name

Pike  
county well located

LANDOWNER: *C. L. Chambers*

description of formations encountered

from to

*Route 2 - McComb*

<i>Red Clay</i>	<i>0</i>	<i>30</i>
<i>Red sand</i>	<i>30</i>	<i>120</i>
<i>Coarse sand &amp; gravel</i>	<i>130</i>	<i>140</i>

*Route; Progress*  
(mailing address)

WELL LOCATION:


sec. *19* T. *2* N. R. *9* E  
#  
*12* miles *E* of *Mayfield*  
(distance) (direction) (nearest town)

WELL PURPOSE: *Home*  
(home, irrigation, municipal, industrial)

WELL COMPLETION DATA:

- (1) diameter (inches) *4*
- (2) total depth (feet) *142*
- (3) static water level (feet) *95* below top of ground.
- (4) casing *Plastic*, *134*,  
(material) (depth)  
*4"* if telescope see back.  
(size)
- (5) screen *8*, *134*  
(length) (depth to top)  
*4"*, *Plastic*  
(size) (material)
- (6) pump *?*, *?*  
(HP) (yield gpm)  
*Electric*  
(type power)
- (7) electric log *no*  
(yes or no)  
(organization running log)
- (8) how well bottom plugged *well log*


CODED

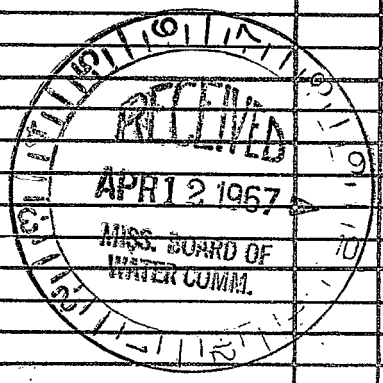

DRILLERS REMARKS:

If well telescopes please sketch and show depths.

GROUND LEVEL

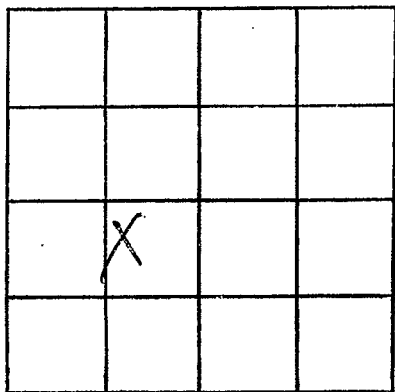

SECTION 19

Please indicate well location X.

ADDITIONAL INFORMATION

If more than one screen, show locations of each on sketch.