

CODER

MISSISSIPPI
BOARD OF WATER COMMISSIONERS
416 North State Street
Jackson, Mississippi 39201

WATER WELL DRILLERS LOG

Pike
8-67

Aug 15 date well completed 19 67 FITZGERALD WATERWELL firm name PIKE county well located

LANDOWNER: HARDY SMITH

description of formations encountered

from

to

Rt 3 Magnolia, Miss
(mailing address)

<u>Red clay</u>	<u>0</u>	<u>30</u>
<u>Red sand</u>	<u>30</u>	<u>70</u>
<u>Green sand & gravel</u>	<u>70</u>	<u>105</u>
<u>fine red sand</u>	<u>105</u>	<u>180</u>
<u>Coarse sand & gravel</u>	<u>180</u>	<u>195</u>

WELL LOCATION:

sec. 19 T 2 N R 9 E
S W
10 miles E of MAGNOLIA
(distance) (direction) (nearest town)


WELL PURPOSE: Home
(home, irrigation, municipal, industrial)

WELL COMPLETION DATA:

- (1) diameter (inches) 4
- (2) total depth (feet) 195
- (3) static water level (feet) 100 ^{'below} / _{'above} top of ground.
- (4) casing Plastic, 189
(material) (depth)
4"
(size) if telescope see back.
- (5) screen 6', 189'
(length) (depth to top)
4", Plastic
(size) (material)
- (6) pump 1 7 GPM
(HP) (yield gpm)
Electric
(type power)
- (7) electric log No
(yes or no)
- (8) how well bottom plugged wood peg


CODER

DRILLERS REMARKS:

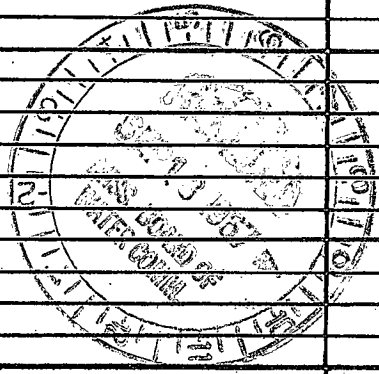

If well telescopes please sketch and show depths.

GROUND LEVEL

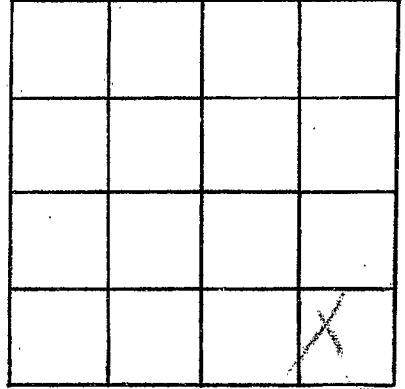

SECTION 109

Please indicate well location X.

ADDITIONAL INFORMATION

If more than one screen,
show locations of each on sketch.