

CODED
 Piche
 J10
 1-68

MISSISSIPPI
 BOARD OF WATER COMMISSIONERS
 416 North State Street
 Jackson, Mississippi 39201

WATER WELL DRILLERS LOG

1-30 1968 date well completed
 68 Elycross Water Well Piche firm name
 Piche county well located

LANDOWNER: Josie Jolley
 R2 McComb Miss

| description of formations encountered | from | to |
|---------------------------------------|------|-----|
| top soil/clay | 0 | 15 |
| Sand | 15 | 42 |
| gravel | 42 | 65 |
| Open gravel | 65 | 72 |
| gravel & sand | 72 | 104 |
| Red | 104 | 106 |
| Red Chalk | 106 | 122 |
| White Chalk | 122 | 168 |
| Fine sand | 168 | 188 |
| Crushed sand - gravel | 188 | 220 |

(mailing address)

WELL LOCATION:


sec 4 T 2 N R 9 E
 S W
 12 miles ESE of McComb
 (distance) (direction) (nearest town)

WELL PURPOSE: home
 (home, irrigation, municipal, industrial)

WELL COMPLETION DATA:

- diameter (inches) 4
- total depth (feet) 220
- static water level (feet) 200 below top of ground.
- casing plastic 2 1/4 (material) (depth)
4 (size) if telescope see back.
- screen 6" 2 1/4 (length) (depth to top)
4 (size) 5ch 40 (material)
- pump 3/4 HP 3 (HP) (yield gpm)
Spec (type power)
- electric log yes (yes or no)
- how well bottom plugged Word peg


CODED

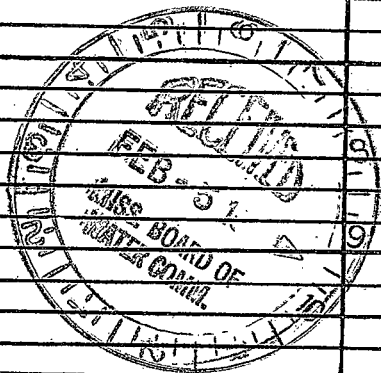

DRILLERS REMARKS:

If well telescopes please sketch and show depths.

GROUND LEVEL

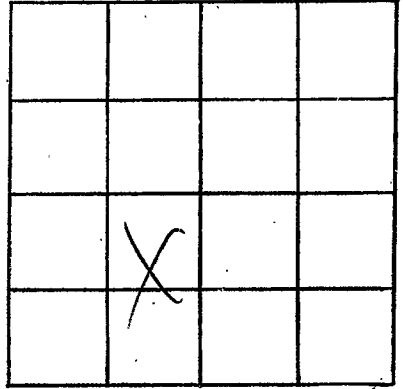

SECTION *12*

Please indicate well location X.

ADDITIONAL INFORMATION

If more than one screen, show locations of each on sketch.