

CODED

Pike

J13

1-68

**MISSISSIPPI
BOARD OF WATER COMMISSIONERS**
416 North State Street
Jackson, Mississippi 39201

WATER WELL DRILLERS LOG

Jan 30 1968 Fitzgerald well serv. Pike
 date well completed firm name county well located

LANDOWNER: Richmond Yarn

description of formations encountered	from	to
<u>Red Clay</u>	<u>0</u>	<u>5</u>
<u>Red Sand</u>	<u>5</u>	<u>55</u>
<u>Coarse sand & gravel</u>	<u>55</u>	<u>65</u>
<u>Red sand</u>	<u>65</u>	<u>98</u>
<u>Coarse sand & gravel</u>	<u>98</u>	<u>105</u>
<u>Red sand</u>	<u>105</u>	<u>108</u>
<u>Coarse sand & gravel</u>	<u>108</u>	<u>126</u>

RT 2, McComb, Miss.
 (mailing address)


WELL LOCATION:
 sec. 9 T 2 N R. 9 E
9 miles ESE of McComb
 (distance) (direction) (nearest town)

WELL PURPOSE: Home
 (home, irrigation, municipal, industrial)

WELL COMPLETION DATA:

- (1) diameter (inches) 4
- (2) total depth (feet) 126
- (3) static water level (feet) 100 below top of ground.
- (4) casing Plastic, 120,
 (material) (depth)
4"
 (size) if telescope see back.
- (5) screen 6", 120'
 (length) (depth to top)
4", Plastic
 (size) (material)
- (6) pump 1 3
 (HP) (yield gpm)
Elec
 (type power)
- (7) electric log No
 (yes or no)
 (organization running log)
- (8) how well bottom plugged wood Reg

DRILLERS REMARKS:

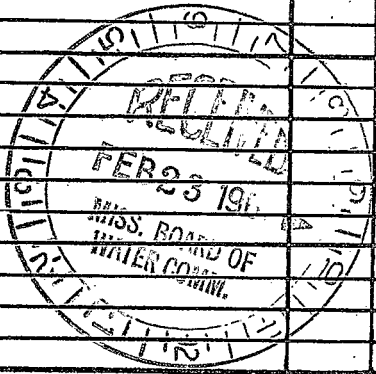

If well telescopes please sketch and show depths.

GROUND LEVEL

X			

SECTION 9

Please indicate well location X.

ADDITIONAL INFORMATION

If more than one screen, show locations of each on sketch.