

PIKE  
 514  
 2-22-71

MISSISSIPPI  
 BOARD OF WATER COMMISSIONERS  
 416 North State Street  
 Jackson, Mississippi 39201

**CODED**

WATER WELL DRILLERS LOG

Feb 27 1971 Chester Keene Pike  
 date well completed firm name county well located

LANDOWNER: John Miller  
At-1, Mapala  
 (mailing address)

description of formations encountered	from	to
Red clay	0	22
Red chunky sand	22	60
Red clay	60	117
Sand & gravel	117	127

WELL LOCATION:  
 sec 24 T 2 N R 9 E  
9 miles SE of Mapala  
 (distance) (direction) (nearest town)

WELL PURPOSE: Home  
 (home, irrigation, municipal, industrial)

- WELL COMPLETION DATA:
- (1) diameter (inches) 4"
  - (2) total depth (feet) 127
  - (3) static water level (feet) 100 below top of ground.
  - (4) casing Plast Bottom  
 (material) (depth)
  - (size) if telescope see back.
  - (5) screen 6' 127'  
 (length) (depth to top)  
1/2" Plastic  
 (size) (material)
  - (6) pump 1/2 Sub 10  
 (HP) (yield gpm)  
elect  
 (type power)
  - (7) electric log No  
 (yes or no)
- (organization running log)

**CODED**

(8) how well bottom plugged  
wooden plug


APR 27 1971

DRILLERS REMARKS:  
old 2" well had

MISS. BD. OF  
 WATER COMM.

If well telescopes please sketch and show depths.

GROUND LEVEL

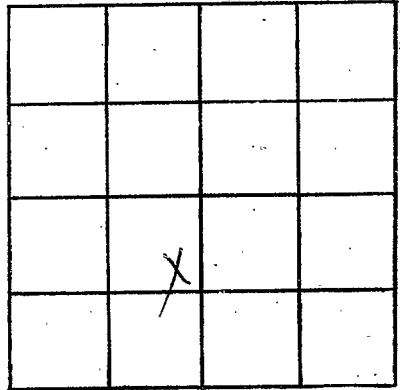

SECTION 29

Please indicate well location X.

ADDITIONAL INFORMATION

If more than one screen, show locations of each on sketch.