

PIKE
 916
 8-68

MISSISSIPPI
 BOARD OF WATER COMMISSIONERS
 416 North State Street
 Jackson, Mississippi 39201

WATER WELL DRILLERS LOG

8-15 date well completed
 1968 firm name
 18 Fitzgerald Well Works pike county well located

LANDOWNER: Willie Brady
 Magnolia Rt MISS

description of formations encountered	from	to
topsoil & clay	0	20
Red Sand	20	80
gravel & sand	80	100
fine sand	100	125
pebbles & sand	125	140


(mailing address)

WELL LOCATION:
 sec. 17 T 2 N R 9 E
 S W
 8 miles E of Magnolia
 (distance) (direction) (nearest town)

WELL PURPOSE: home
 (home, irrigation, municipal, industrial)

- WELL COMPLETION DATA:
- (1) diameter (inches) 4
 - (2) total depth (feet) 137
 - (3) static water level (feet) 80 below top of ground.
 - (4) casing plastic 137 (material) (depth)
 - 2" if telescope see back. (size)
 - (5) screen 6' 137 (length) (depth to top)
 - 4" sch 40 (size) (material)
 - (6) pump (HP) (yield gpm)
 Elec (type power)
 - (7) electric log No (yes or no)
 - (organization running log)
 - (8) how well bottom plugged Wood Peg-

CODED

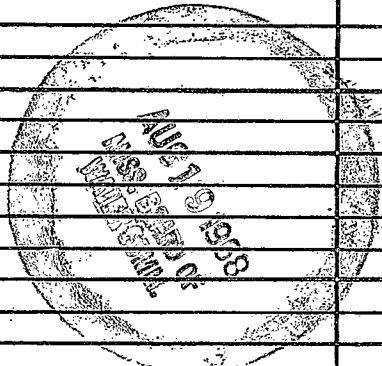

DRILLERS REMARKS:

