

Pike
 8 1700ED
 7-68

MISSISSIPPI
 BOARD OF WATER COMMISSIONERS
 416 North State Street
 Jackson, Mississippi 39201

WATER WELL DRILLERS LOG

July 1 1968 J. T. Covington P. 15e
 date well completed firm name county well located

LANDOWNER: Hubert Strickland
Maguire, Miss
 (mailing address)

description of formations encountered	from	to
clay sand	0	13-
	13-	18-


WELL LOCATION:
 sec 19 T 2 N R 9 E
 C NE S NE W
0 miles East of Maguire
 (distance) (direction) (nearest town)

WELL PURPOSE:
 (home, irrigation, municipal, industrial)

- WELL COMPLETION DATA:
- (1) diameter (inches) 4"
 - (2) total depth (feet) 65'
 - (3) static water level (feet) 25' below top of ground.
 - (4) casing Plastic 59'
 (material) (depth)
4" if telescope see back.
 (size)
 - (5) screen 6' 65'
 (length) (depth to top)
4" Plastic
 (size) (material)
 - (6) pump 1/2 6
 (HP) (yield gpm)
A.C.
 (type power)
 - (7) electric log _____
 (yes or no)

 (organization running log)
 - (8) how well bottom plugged wood

CODED

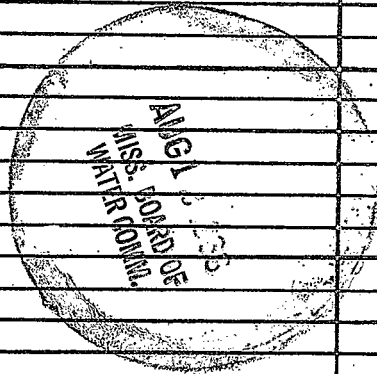

DRILLERS REMARKS:

If well telescopes please sketch and show depths.

GROUND LEVEL



SECTION 14

Please indicate well location X.

ADDITIONAL INFORMATION

If more than one screen, show locations of each on sketch.