

PIKE

MISSISSIPPI BOARD OF WATER COMMISSIONERS

818 CODED
7-6-64

CODED

WATER WELL DRILLERS LOG

Date: 7-6, 1964, Driller: Chester Reeves, Pike County

(Name)

(1) Owner of Land: ERNEST Mc Lamb
Rt 2, McComb
(Name)
(Address)

Description & Color of Materials
Sand, Clay, Red Clay, Shell, etc.

Thick-
ness
Feet

Depth
Feet

70 70
80 100
Sand & gravel
Clay
21 121

(2) Location: 1/4, 1/4, Sec. 5 2 9
12 miles S.E. of McComb
(distance) (direction) (Nearest Town)

(3) Topography: Hilly
(Hilly) (Flat) (Level)

(4) Purpose of Well: Domestic
(Domestic Irrigation
Municipal, Industrial, Other)

Information upon completion of well:

(1) Diameter: 4 1/2 inches.

(2) Total Depth: 121 feet.

(3) Water Level: 80 feet below top of ground.

Cannot locate
R4

(4) Cased to: Bottom, Size 4"


(5) Screen: Size NONE, Length -

(6) Were any formations sealed against pollution?
yes, no.

If YES depth of formation

Why

Drillers Remarks: Bad - Drill

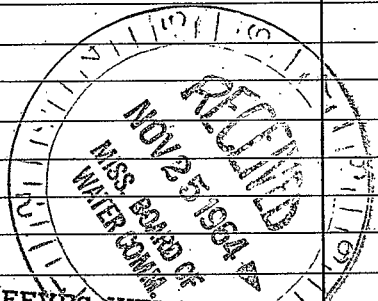

REEVES WELL & PUMP CO.
P. O. BOX 51 PHONE 684-1451
McCOMB, MISS.

(Use Back Side)

Well No.

