

CODED

PIKE  
J20  
9-10-68

MISSISSIPPI  
BOARD OF WATER COMMISSIONERS  
416 North State Street  
Jackson, Mississippi 39201

WATER WELL DRILLERS LOG

Sept-10 1968 J.T. Livingston Pithe  
date well completed firm name county well located

LANDOWNER: Joe Brown Field

description of formations encountered from to  
6/12 y Sand & Shales 0 35  
25 128


M.C. Lamb, Miss.  
(mailing address)

WELL LOCATION:  
sec. 7 T 2 N R 9 E  
NE S SE W  
1.2 miles East of M.C. Lamb  
(distance) (direction) (nearest town)

WELL PURPOSE: Home  
(home, irrigation, municipal, industrial)

WELL COMPLETION DATA:


- (1) diameter (inches) 4"
- (2) total depth (feet) 129'
- (3) static water level (feet) 90' below top of ground
- (4) casing Plastic 122'  
(material) (depth)  
(size) if telescope see back.
- (5) screen 6' 122'  
(length) (depth to top)  
4" Plastic  
(size) (material)
- (6) pump 1/2 5  
(HP) (yield gpm)  
A.C.  
(type power)
- (7) electric log \_\_\_\_\_  
(yes or no)  
(organization running log)
- (8) how well bottom plugged wood

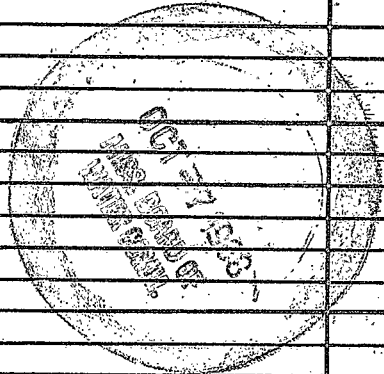

DRILLERS REMARKS:

If well telescopes please sketch and show depths.

GROUND LEVEL

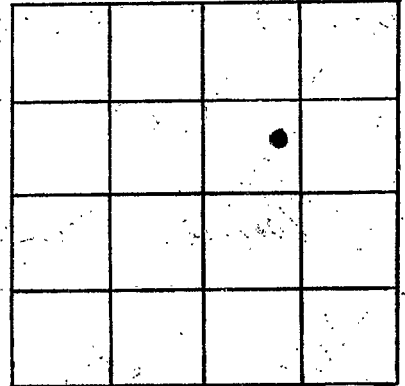

SECTION 2

Please indicate well location X.

ADDITIONAL INFORMATION

If more than one screen, show locations of each on sketch.