

Pike Co
 J 21
 4-15-70

MISSISSIPPI
 BOARD OF WATER COMMISSIONERS
 416 North State Street
 Jackson, Mississippi 39201

CODED

WATER WELL DRILLERS LOG

apr 15
 date well completed

1970 *Fitzgibbon Well Serv*
 firm name

Pike
 county well located

LANDOWNER:

T. J. Jordan
B.R. Stephens, Jr.
 (mailing address)

description of formations encountered

from

to

<i>Red clay</i>	<i>0</i>	<i>25</i>
<i>Red sand</i>	<i>20</i>	<i>80</i>
<i>Red gravel</i>	<i>80</i>	<i>115</i>
<i>Coarse sand & gravel</i>	<i>115</i>	<i>124</i>

WELL LOCATION:

sec. *35* T *2* N R *9* E
9 miles *WSW* of *Fountain*
 (distance) (direction) (nearest town)

WELL PURPOSE:

Home
 (home, irrigation, municipal, industrial)

WELL COMPLETION DATA:

- (1) diameter (inches) *4*
- (2) total depth (feet) *124*
- (3) static water level (feet) *80* below above top of ground.
- (4) casing *Plastic 118*
 (material) (depth)
4 if telescope see back.
 (size)
- (5) screen *6 118*
 (length) (depth to top)
4
 (size) (material)
- (6) pump *1/2 6*
 (HP) (yield gpm)
600
 (type power)
- (7) electric log *no*
 (yes or no)
 (organization running log)
- (8) how well bottom plugged *wood plug*

CODED


APR 29 1970

DRILLERS REMARKS:

MISS. BD. OF
 WATER COMM.

If well telescopes please sketch and show depths.

GROUND LEVEL

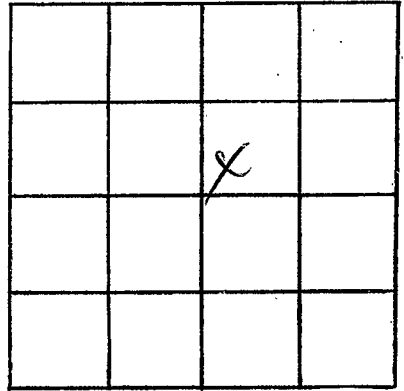

SECTION 35

Please indicate well location X.

ADDITIONAL INFORMATION

If more than one screen,
show locations of each on sketch.