

PIKE

J 23

8-19-70

MISSISSIPPI
 BOARD OF WATER COMMISSIONERS
 416 North State Street
 Jackson, Mississippi 39201

CODED

WATER WELL DRILLERS LOG

8-19

1970

Fitzgerald & Son, Inc.
firm name

Pike
county well located

LANDOWNER:

Alfred Williams

P.R. 2. m Comb, Miss.
(mailing address)

WELL LOCATION:

sec. 8 T. 20 N. R. 9 E.

8 miles E of Comb
(distance) (direction) (nearest town)

WELL PURPOSE: Home
(home, irrigation, municipal, industrial)

WELL COMPLETION DATA:

- (1) diameter (inches) 4
- (2) total depth (feet) 143
- (3) static water level (feet) 100 below above top of ground
- (4) casing Plastic 135
(material) (depth)

4 if telescope see back.
(size)

- (5) screen 8 135
(length) (depth to top)
- 4 Plastic
(size) (material)

- (6) pump 1 6
(HP) (yield gpm)

Electric
(type power)

- (7) electric log yes
(yes or no)

(organization running log)

- (8) how well bottom plugged wood peg

description of formations encountered

from

to

Red clay	0	20
Red sand	20	90
Red gravel	90	110
Red sand	110	132
Course sand & gravel	132	143

CODED


SEP 14 1970

DRILLERS REMARKS:

MISS. BD. OF
WATER COMM.

If well telescopes please sketch and show depths.

GROUND LEVEL

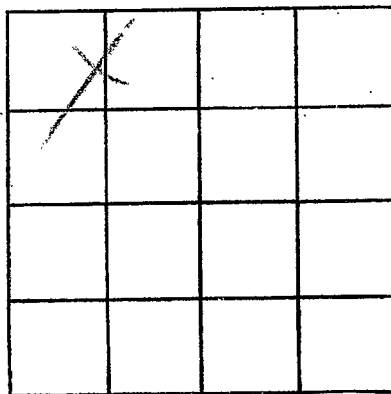

SECTION 5

Please indicate well location X.

ADDITIONAL INFORMATION

If more than one screen, show locations of each on sketch.