

Pike
 J 24
 5-30-70

MISSISSIPPI
 BOARD OF WATER COMMISSIONERS
 416 North State Street
 Jackson, Mississippi 39201

CODED

WATER WELL DRILLERS LOG

May 30 1970 Chester Kerns Pike
 date well completed firm name county well located

LANDOWNER: Alice Holmes
RFD, Magnolia

(mailing address)

WELL LOCATION:

sec. 30 T. 2 N. R. 9 E
9 miles SE Magnolia
 (distance) (direction) (nearest town)

WELL PURPOSE: Home
 (home, irrigation, municipal, industrial)

WELL COMPLETION DATA:

- (1) diameter (inches) 4"
- (2) total depth (feet) 135
- (3) static water level (feet) 98 below above top of ground.
- (4) casing Plastic Bottom-
 (material) (depth)
- _____ If telescope see back.
 (size)
- (5) screen 6' 129'
 (length) (depth to top)
4" Plastic
 (size) (material)
- (6) pump 1/2 HP 10
 (HP) (yield gpm)
Elect.
 (type power)
- (7) electric log no
 (yes or no)

(organization running log)

(8) how well bottom plugged
wood chips

DRILLERS REMARKS:
Edwell had


description of formations encountered	from	to
	<u>Red clay</u>	<u>0</u>
<u>Red Sand</u>	<u>18</u>	<u>40</u>
<u>Sand & gravel</u>	<u>40</u>	<u>60</u>
<u>Red chalk</u>	<u>60</u>	<u>85</u>
<u>Sand & peagran</u>	<u>85</u>	<u>135</u>

CODED

1111 27 1070

If well telescopes please sketch and show depths.

GROUND LEVEL

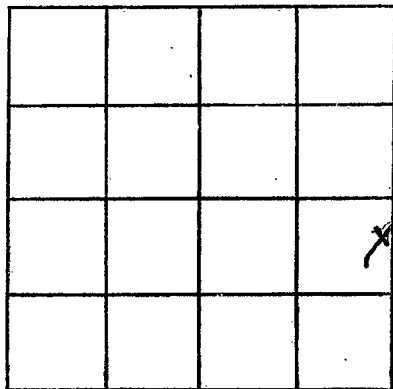

SECTION 30

Please indicate well location X.

ADDITIONAL INFORMATION

If more than one screen,
show locations of each on sketch.