

Pike  
J 25  
6-23-70

MISSISSIPPI  
BOARD OF WATER COMMISSIONERS  
416 North State Street  
Jackson, Mississippi 39201

**CODED**

WATER WELL DRILLERS LOG

6-23 1970 To Fitzgerald wells firm name Pike county well located

LANDOWNER:  
Alfred Meyer Jr.  
(mailing address)

WELL LOCATION:  
sec. 19 T 2 N R 9 E  
9 miles E of Magnolia  
(distance) (direction) (nearest town)

WELL PURPOSE:  
(home, irrigation, municipal, industrial)

- WELL COMPLETION DATA:
- (1) diameter (inches) 4
  - (2) total depth (feet) 132
  - (3) static water level (feet) 118 below top of ground.
  - (4) casing 126 (material) (depth)  
4 (size) if telescope see back.
  - (5) screen 6 (length) 136 (depth to top)  
4 (size) (material)
  - (6) pump 1/2 (HP) 8 (yield gpm)  
Electric (type power)
  - (7) electric log (yes or no)
  - (8) how well bottom plugged

description of formations encountered	from	to
Red clay	0	20
Red sand	20	60
Red gravel	60	90
Red sand	90	120
Coarse sand & gravel	120	132

**CODED**


DRILLERS REMARKS:

JUN 29 1970

MISS. BD. OF WATER COM.

If well telescopes please sketch and show depths.

GROUND LEVEL

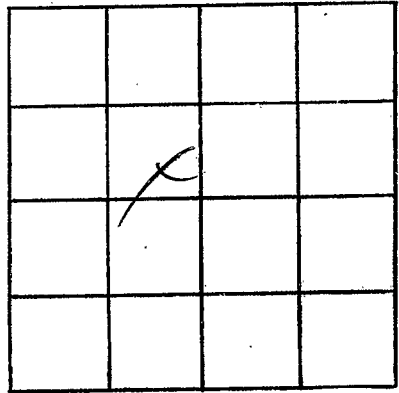

SECTION 19

Please indicate well location X.

ADDITIONAL INFORMATION

If more than one screen,  
show locations of each on sketch.