

Pike Co
 J 26
 7-6-70

MISSISSIPPI
 BOARD OF WATER COMMISSIONERS
 416 North State Street
 Jackson, Mississippi 39201

CODED

WATER WELL DRILLERS LOG

7-6 19 To Fitzgerald Well Co Pike
 date well completed firm name county well located

LANDOWNER:
 Alberto Taylor
 B.R. Magnolia Inn
 (mailing address)

description of formations encountered	from	to
Red Clay	0	20
Red Sand	20	90
Red gravel	90	140
Red Sand	140	160
Coarse Sand & Gravel	160	170

WELL LOCATION:
 sec. 19 T 2 N R 9 E
 9 miles E of Magnolia
 (distance) (direction) (nearest town)

WELL PURPOSE: Home
 (home, irrigation, municipal, industrial)

- WELL COMPLETION DATA:
- (1) diameter (inches) 4
 - (2) total depth (feet) 170
 - (3) static water level (feet) 120 below top of ground.
 - (4) casing plastic, 162, (material) (depth)
 4 (size) if telescope see back.
 - (5) screen 8, 162, (length) (depth to top)
 4 (size) plastic (material)
 - (6) pump 1/2, 8, (HP) (yield gpm)
 el (type power)
 - (7) electric log (yes or no) no
 (organization running log)
 - (8) how well bottom plugged Goodly

CODED


DRILLERS REMARKS:

JUL 24 1970

MISSISSIPPI
 BOARD OF WATER COMMISSIONERS
 WATER COUNTY

If well telescopes please sketch and show depths.

GROUND LEVEL

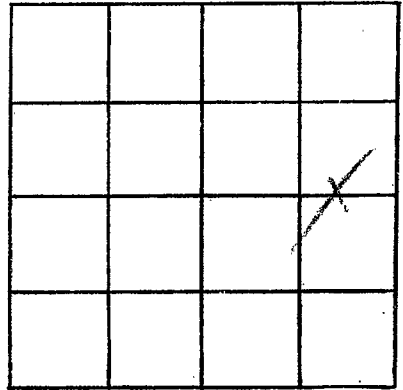

SECTION 19

Please indicate well location X.

ADDITIONAL INFORMATION

If more than one screen, show locations of each on sketch.