

MISSISSIPPI
 BOARD OF WATER COMMISSIONERS
 416 North State Street
 Jackson, Mississippi 39201

CODED

WATER WELL DRILLERS LOG

PIKE
J 27
6-26-70

June 26 1970 Grenn Water Well Contractor Pike
 date well completed firm name county well located

LANDOWNER:	description of formations encountered	from	to
Wilton Slaven Magnolia, Miss.	Citronelle	0	140
(mailing address)			
WELL LOCATION: sec. 30 T 2 N R 9 E 10 miles east of Magnolia (distance) (direction) (nearest town)			
WELL PURPOSE: home (home, irrigation, municipal, industrial)			
WELL COMPLETION DATA:			
(1) diameter (inches) 6"			
(2) total depth (feet) 140			
(3) static water level (feet) 100 below top of ground.			
(4) casing PVC, 135' (material) (depth) 4" (size) if telescope see back.			
(5) screen 4' (length), 131' (depth to top) 1/2" (size), PVC (material)			
(6) pump did not install (HP) (yield gpm) (type power)			
(7) electric log no (yes or no) (organization running log)			
(8) how well bottom plugged wood			
DRILLERS REMARKS:			


CODED

AUG

MISS. DIV. OF WATER RESOURCES
 WATER RESOURCES

If well telescopes please sketch and show depths.

GROUND LEVEL

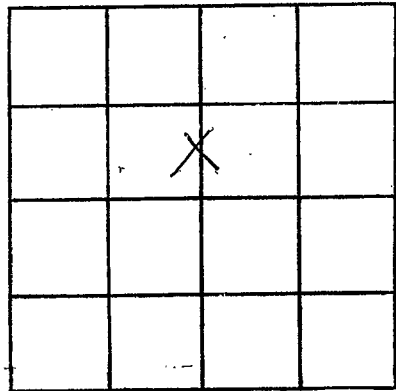

SECTION 30

Please indicate well location X.

ADDITIONAL INFORMATION

If more than one screen,
show locations of each on sketch.