

PIKE  
 T 30  
 9-24-70

MISSISSIPPI  
 BOARD OF WATER COMMISSIONERS  
 416 North State Street  
 Jackson, Mississippi 39201

**CODED**

WATER WELL DRILLERS LOG

9-24 date well completed      1970 firm name      Atty General Well Dr. Pike county well located

LANDOWNER:

Charlie Barnes

P.R. Magnolia, Miss.  
 (mailing address)

description of formations encountered

from to

Red clay	0	20
Red sand	20	90
Coarse sand	90	114

WELL LOCATION:

sec. 17 T 2 N R 9 E  
 10 miles E of Fenwick  
 (distance) (direction) (nearest town)

WELL PURPOSE: Home  
 (home, irrigation, municipal, industrial)

WELL COMPLETION DATA:

- (1) diameter (inches) 4
- (2) total depth (feet) 114
- (3) static water level (feet) 60 below top of ground.
- (4) casing Plastic 108 (material) (depth)  
 4 (size) if telescope see back.
- (5) screen 6 108 (length) (depth to top)  
 4 (size) Plastic (material)
- (6) pump Bucket (HP) (yield gpm)  
 Hand (type power)
- (7) electric log No (yes or no)  
 (organization running log)
- (8) how well bottom plugged Wood peg

**CODED**


OCT 16 1970

DRILLERS REMARKS:

MISS. BD. OF  
 WATER COM.

If well telescopes please sketch and show depths.

GROUND LEVEL

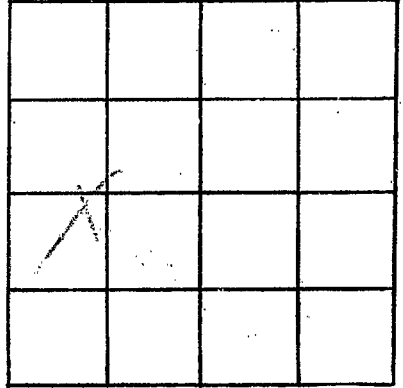

SECTION 17

Please indicate well location X.

ADDITIONAL INFORMATION

If more than one screen, show locations of each on sketch.