

PIKE  
 J31  
 10-2-70

MISSISSIPPI  
 BOARD OF WATER COMMISSIONERS  
 416 North State Street  
 Jackson, Mississippi 39201

**CODED**

WATER WELL DRILLERS LOG

Oct 2 1970 To Etzwell Drilling firm name Pike county well located

LANDOWNER:

Neal Barnes

(mailing address)

WELL LOCATION:

sec. 35 T. 2 N. R. 9 E

12 miles E of Magnolia  
 (distance) (direction) (nearest town)

WELL PURPOSE:

Home  
 (home, irrigation, municipal, industrial)

WELL COMPLETION DATA:

- (1) diameter (inches) 4
- (2) total depth (feet) 123
- (3) static water level (feet) 80 below top of ground.
- (4) casing plastic, 117,  
 (material) (depth)  
4 if telescope see back.  
 (size)
- (5) screen 6, 217,  
 (length) (depth to top)  
4, plastic  
 (size) (material)
- (6) pump 1/2, 9  
 (HP) (yield gpm)  
elm  
 (type power)
- (7) electric log no  
 (yes or no)  
 (organization running log)
- (8) how well bottom plugged woody

description of formations encountered

from to

<u>Red clay</u>	<u>6</u>	<u>20</u>
<u>Red sand</u>	<u>20</u>	<u>70</u>
<u>Red gravel</u>	<u>20</u>	<u>115</u>
<u>Coarse sand</u>	<u>115</u>	<u>123</u>

**CODED**


OCT 16 1970

DRILLERS REMARKS:

MISS. BD. OF  
 WATER COMM.

If well telescopes please sketch and show depths.

GROUND LEVEL

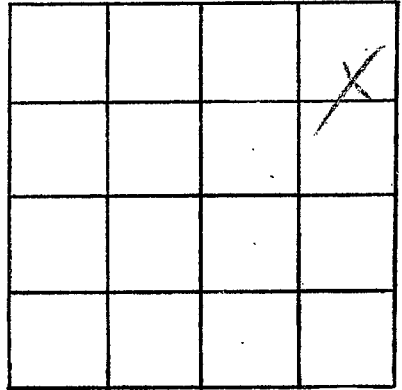

SECTION 35

Please indicate well location X.

ADDITIONAL INFORMATION

If more than one screen, show locations of each on sketch.