

PIKE
J 32
11-5-70

MISSISSIPPI
BOARD OF WATER COMMISSIONERS
416 North State Street
Jackson, Mississippi 39201

CODED

WATER WELL DRILLERS LOG

11-5 1970 *Fitzgerald well Co* *Pike*
date well completed firm name county well located

LANDOWNER:
J. E. Mayer
R.R. Magnolia
(mailing address)

description of formations encountered	from	to
<i>Red clay</i>	<i>0</i>	<i>20</i>
<i>Red sand</i>	<i>20</i>	<i>45</i>
<i>Coarse sand & gravel</i>	<i>45</i>	<i>153</i>

WELL LOCATION:
sec. *33*T *2*^N *5* R *9*^E *W*
11 miles *E* of *Magnolia*
(distance) (direction) (nearest town)

WELL PURPOSE: *Home*
(home, irrigation, municipal, industrial)

- WELL COMPLETION DATA:
- (1) diameter (inches) *4*
 - (2) total depth (feet) *153*
 - (3) static water level (feet) *110* below top of ground.
 - (4) casing *plastic*, *145*,
(material) (depth)
4 if telescope see back.
(size)
 - (5) screen *8*, *145*
(length) (depth to top)
4, *plastic*
(size) (material)
 - (6) pump *1*, *13*
(HP) (yield gpm)
cl
(type power)
 - (7) electric log *no*
(yes or no)
(organization running log)
 - (8) how well bottom plugged *wood plug*

CODED


NOV 9 - 1970

DRILLERS REMARKS:

MISS. BD. OF
WATER COMM.

If well telescopes please sketch and show depths.

GROUND LEVEL

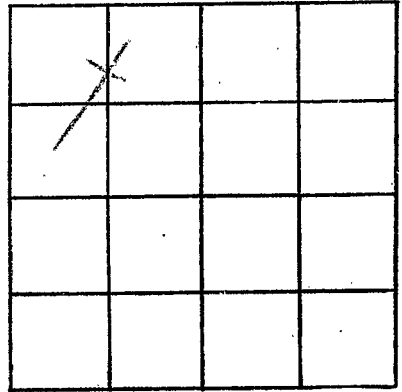

SECTION 3

Please indicate well location X.

ADDITIONAL INFORMATION

at 7 min. Lat of a R₂

If more than one screen, show locations of each on sketch.