

PIKE  
J 33  
9-24-70

MISSISSIPPI  
BOARD OF WATER COMMISSIONERS  
416 North State Street  
Jackson, Mississippi 39201

**CODED**

WATER WELL DRILLERS LOG

Sept 24, 1970 *Chester Keene* *Pike*  
date well completed firm name county well located

LANDOWNER: *Huston*  
*Banner*  
*AT&T Magnolia*  
(mailing address)

description of formations encountered	from	to
<i>Red clay</i>	<i>0</i>	<i>18</i>
<i>Red sand</i>	<i>18</i>	<i>55</i>
<i>Sand &amp; gravel</i>	<i>55</i>	<i>68</i>
<i>fine sandy sand</i>	<i>68</i>	<i>96</i>
<i>Sand &amp; pebbles</i>	<i>96</i>	<i>114</i>

WELL LOCATION:  
sec *31* T *2* N R *9* E  
*7* miles *SE* of *Magnolia*  
(distance) (direction) (nearest town)

WELL PURPOSE: *Home*  
(home, irrigation, municipal, industrial)

- WELL COMPLETION DATA:
- (1) diameter (inches) *4"*
  - (2) total depth (feet) *114*
  - (3) static water level (feet) *71* below top of ground above
  - (4) casing *Plastic Bottom*  
(material) (depth)
  - (size) if telescope see back.
  - (5) screen *6'* *108*  
(length) (depth to top)
  - 4"* *Plastic*  
(size) (material)
  - (6) pump *1/2* *12*  
(HP) (yield gpm)
  - Steel*  
(type power)
  - (7) electric log *no*  
(yes or no)
  - (organization running log)

**CODED**


(8) how well bottom plugged  
*wooden plug*

DRILLERS REMARKS:  
*New house*

NOV 16 1970

If well telescopes please sketch and show depths.

GROUND LEVEL

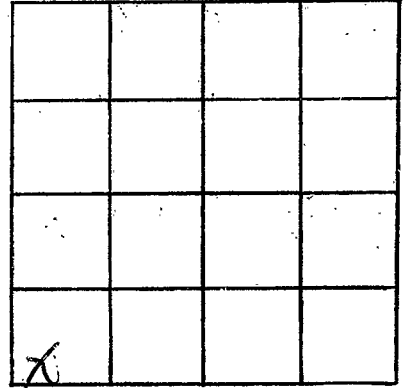

SECTION 31

Please indicate well location X.

ADDITIONAL INFORMATION

If more than one screen,  
show locations of each on sketch.