

PIKE

~~Walthall~~
J-34
 1-68

MISSISSIPPI
 BOARD OF WATER COMMISSIONERS
 416 North State Street
 Jackson, Mississippi 39201

CODED

WATER WELL DRILLERS LOG

PIKE
Walthall

Jan 31 1968 date well completed
 Fitzgerald Well Co. firm name
 county well located

LANDOWNER: James Bradley
 RR Tylertown, Miss
 (mailing address)


description of formations encountered	from	to
Red Clay	0	20
Red Silica Sand	20	60
Red gravel	60	70
Coarse Sand + gravel + Sand beds	70	98

WELL LOCATION:
 sec. 34 T. 2 N. R. 9 E.
 12 miles E of Magnolia
 (distance) (direction) (nearest town)

WELL PURPOSE: Home
 (home, irrigation, municipal, industrial)

- WELL COMPLETION DATA:
- (1) diameter (inches) 4
 - (2) total depth (feet) 98
 - (3) static water level (feet) 75 below top of ground.
 - (4) casing Plastic, 92' (material) (depth)
 4" (size) if telescope see back.
 - (5) screen 6' (length), 92' (depth to top)
 4" (size), Plastic (material)
 - (6) pump 7 (HP), 7 (yield gpm)
 Class (type power)
 - (7) electric log No (yes or no)
 (organization running log)
 - (8) how well bottom plugged 2 sand feet


CODED

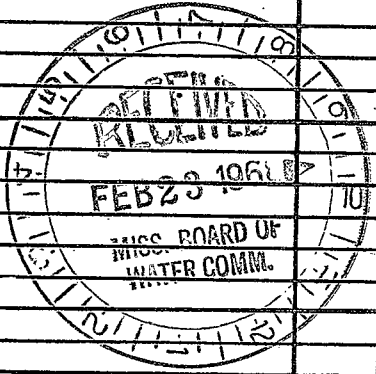

DRILLERS REMARKS:

If well telescopes please
sketch and show depths.

GROUND LEVEL

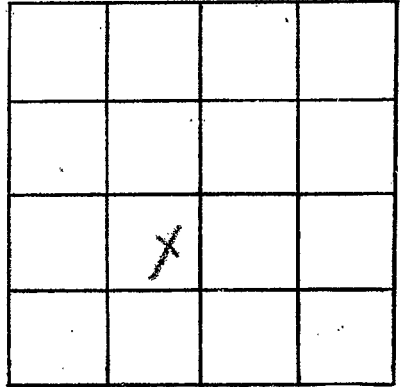

SECTION 34

Please indicate well location X.

ADDITIONAL INFORMATION

If more than one screen,
show locations of each on sketch.