

**PIKE**  
**J 35**  
**9-30-70**

MISSISSIPPI  
 BOARD OF WATER COMMISSIONERS  
 416 North State Street  
 Jackson, Mississippi 39201

**CODED**

**WATER WELL DRILLERS LOG**

Sept 30 1970 J.T. Covington & Son Pike  
 date well completed firm name county well located

**LANDOWNER:**  
 Guy Wilson  
 McComb, Miss  
 (mailing address)

description of formations encountered	from	to
	Clay	0
Chalk	30	70
GRAVEL	70	120
SAND + GRAVEL	120	135

**WELL LOCATION:**  
 sec. 16 T. 2 N. R. 9 E  
 12 miles 3/2 of McComb  
 (distance) (direction) (nearest town)

**WELL PURPOSE:** Home  
 (home, irrigation, municipal, industrial)

- WELL COMPLETION DATA:**
- (1) diameter (inches) 4"
  - (2) total depth (feet) 135
  - (3) static water level (feet) 120 below top of ground.
  - (4) casing (material) pl, (depth) 129
  - (size) If telescope see back.
  - (5) screen (length) 6', (depth to top) 129
  - (size) 4" (material) pl
  - (6) pump (HP) 1/2 (yield gpm) 10
  - (type power) Elect
  - (7) electric log (yes or no) No
  - (organization running log)
  - (8) how well bottom plugged Wood

**CODED**


DEC 11 1970

**DRILLERS REMARKS:**

MISS. BD. OF  
 WATER COMM.

If well telescopes please sketch and show depths.

GROUND LEVEL

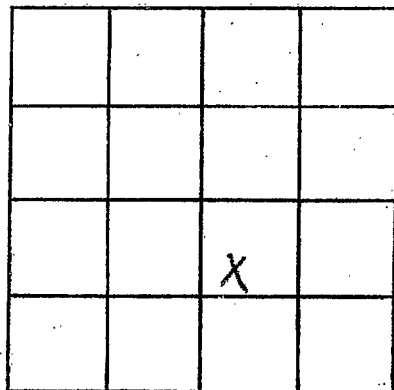

SECTION 16

Please indicate well location X.

ADDITIONAL INFORMATION

If more than one screen, show locations of each on sketch.