

PIKE  
 J 36  
 12-9-70

MISSISSIPPI  
 BOARD OF WATER COMMISSIONERS  
 416 North State Street  
 Jackson, Mississippi 39201

**CODED**

WATER WELL DRILLERS LOG

12-9 19 70 Fitzgerald well #1 Pike  
 date well completed firm name county well located

LANDOWNER: Webb Williams  
RR 200 Camb. Miss.  
 (mailing address)

description of formations encountered	from	to
<u>Red clay</u>	<u>0</u>	<u>20</u>
<u>Red sand</u>	<u>20</u>	<u>90</u>
<u>Red gravel</u>	<u>90</u>	<u>120</u>
<u>Coarse sand &amp; gravel</u>	<u>120</u>	<u>137</u>

WELL LOCATION:  
 sec. 8 T. 2 N. R. 9 E  
3 miles S of Barto  
 (distance) (direction) (nearest town)

WELL PURPOSE: Home  
 (home, irrigation, municipal, industrial)

- WELL COMPLETION DATA:
- (1) diameter (inches) 4
  - (2) total depth (feet) 137
  - (3) static water level (feet) 90 below above top of ground.
  - (4) casing plastic, 129,  
 (material) (depth)  
4 if telescope see back.  
 (size)
  - (5) screen 8, 129  
 (length) (depth to top)  
4, plastic  
 (size) (material)
  - (6) pump 1/2 10  
 (HP) (yield gpm)  
elm  
 (type power)
  - (7) electric log no  
 (yes or no)  
 (organization running log)
  - (8) how well bottom plugged wood

**CODED**


DEC 17 1970

DRILLERS REMARKS:

MISS. Bd. OF  
 WATER COMMISSIONERS

If well telescopes please sketch and show depths.

GROUND LEVEL

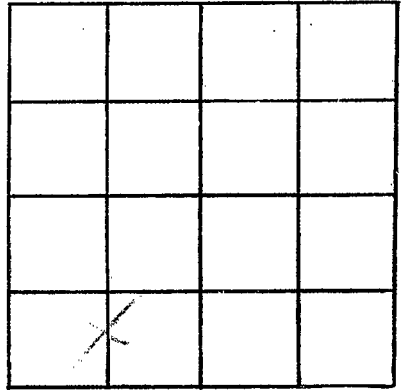

SECTION   2  

Please indicate well location X.

ADDITIONAL INFORMATION

If more than one screen,  
show locations of each on sketch.