

MISSISSIPPI
BOARD OF WATER COMMISSIONERS
416 North State Street
Jackson, Mississippi 39201

CODED

WATER WELL DRILLERS LOG

PIKE
QJ38
10-6-70

oct-6 1970 date well completed
Chater Keener firm name
Pike county well located

LANDOWNER: Lifell
Bannfield
Rt-2, McLamb-
(mailing address)

WELL LOCATION:
sec. 9 T. 7 N. R. 9 E.
9 miles E of Natchez
(distance) (direction) (nearest town)

WELL PURPOSE: Home-
(home, irrigation, municipal, industrial)

WELL COMPLETION DATA:
(1) diameter (inches) 4"
(2) total depth (feet) 141
(3) static water level (feet) 122 below top of ground.
(4) casing Plastic Sattam
(material) (depth)

(size) if telescope see back.
(5) screen 6' 135
(length) (depth to top)
4" Plastic
(size) (material)

(6) pump Installed by owner
(type power) (HP) (yield gpm)

(7) electric log no
(yes or no)

(organization running log)

(8) how well bottom plugged
wood plug

DRILLERS REMARKS:
new house

description of formations encountered	from	to
	clay	0
sand & gravel	10	20
chalk	20	60
Sand & gravel	60	141


CODED

FEB 5 1971

MISS. BD. OF
WATER COMMISSIONERS

If well telescopes please sketch and show depths.

GROUND LEVEL

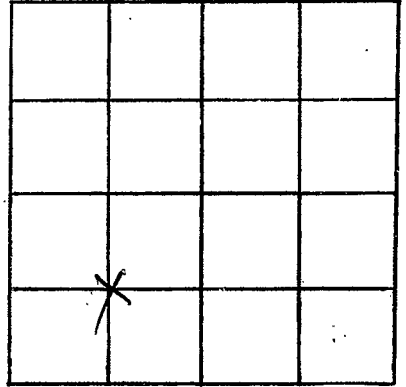

SECTION 9

Please indicate well location X.

ADDITIONAL INFORMATION

If more than one screen,
show locations of each on sketch.