

MISSISSIPPI
BOARD OF WATER COMMISSIONERS
416 North State Street
Jackson, Mississippi 39201

CODED

WATER WELL DRILLERS LOG

PIKE
J 39
11-18-70

NOV. 18 1970 Chester Keene Pike
date well completed firm name county well located

LANDOWNER: L.H. McKeen
Rt-4, Maraha
(mailing address)

WELL LOCATION:
sec 30 T 2 N R 9 E
7 miles SE of Maraha
(distance) (direction) (nearest town)

WELL PURPOSE: Home
(home, irrigation, municipal, industrial)

- WELL COMPLETION DATA:
- (1) diameter (inches) 4"
 - (2) total depth (feet) 152
 - (3) static water level (feet) 76 below above
top of ground.
 - (4) casing Plastic Bottom
(material) (depth)
 - (size) if telescope see back.
 - (5) screen 6 146
(length) (depth to top)
 - 4" Plastic
(size) (material)
 - (6) pump 1/2 Sub 12
(HP) (yield gpm)
 - split
(type power)
 - (7) electric log no
(yes or no)
 - (organization running log)

description of formations encountered	from	to
clay	0	15
sandy shale	15	35
sand	35	45
shale	45	115
chalky gravel	115	140
sand & gravel	140	152

CODED


FEB 4 1971

MISS. DIV. OF
WATER RESOURCES

(8) how well bottom plugged completely
DRILLERS REMARKS: New house.

If well telescopes please sketch and show depths.

GROUND LEVEL

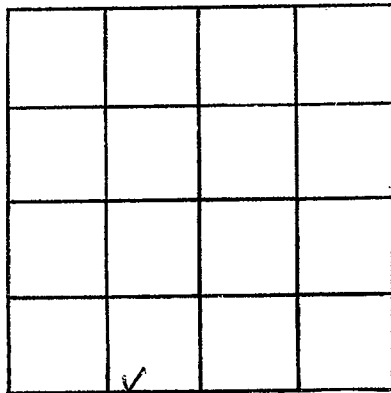

SECTION 30

Please indicate well location X.

ADDITIONAL INFORMATION

If more than one screen, show locations of each on sketch.