

PIKE  
 J 40  
 1-28-71

MISSISSIPPI  
 BOARD OF WATER COMMISSIONERS  
 416 North State Street  
 Jackson, Mississippi 39201

**CODED**

WATER WELL DRILLERS LOG

1-28 1971 *Fitzgerald Well Drilling* *Reke*  
 date well completed firm name county well located

LANDOWNER:  
*Willie Simmons*  
*R.R. McComb, Miss.*  
 (mailing address)

description of formations encountered	from	to
<i>Red clay</i>	<i>0</i>	<i>22</i>
<i>Red sand</i>	<i>26</i>	<i>30</i>
<i>Coarse sand &amp; gravel</i>	<i>32</i>	<i>132</i>

WELL LOCATION:  
 sec. *34* T. *2* N. R. *9* E. *me*  
*S* *W*  
*12* miles *E* of *Myrtle*  
 (distance) (direction) (nearest town)

WELL PURPOSE: *Home*  
 (home, irrigation, municipal, industrial)

- WELL COMPLETION DATA:
- (1) diameter (inches) *4*
  - (2) total depth (feet) *132*
  - (3) static water level (feet) *90* below top of ground.
  - (4) casing *plastic*, *126*,  
 (material) (depth)  
*4* if telescope see back.  
 (size)
  - (5) screen *6*, *126*  
 (length) (depth to top)  
*4*, *plastic*  
 (size) (material)
  - (6) pump *1/2*, *6*  
 (HP) (yield gpm)  
*el.*  
 (type power)
  - (7) electric log *no*  
 (yes or no)
- (organization running log)

**CODED**

(8) how well bottom plugged *completely*


FEB 17 1971

DRILLERS REMARKS:

MISS. Bd. of  
 WATER COMMISSIONERS

If well telescopes please sketch and show depths.

GROUND LEVEL

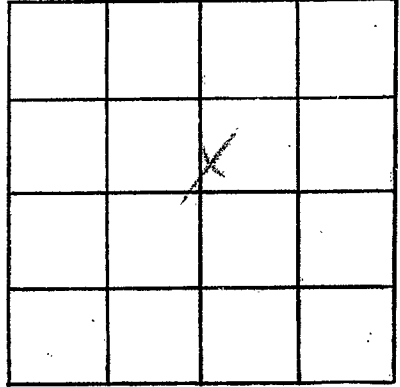

SECTION 34

Please indicate well location X.

ADDITIONAL INFORMATION

If more than one screen, show locations of each on sketch.